
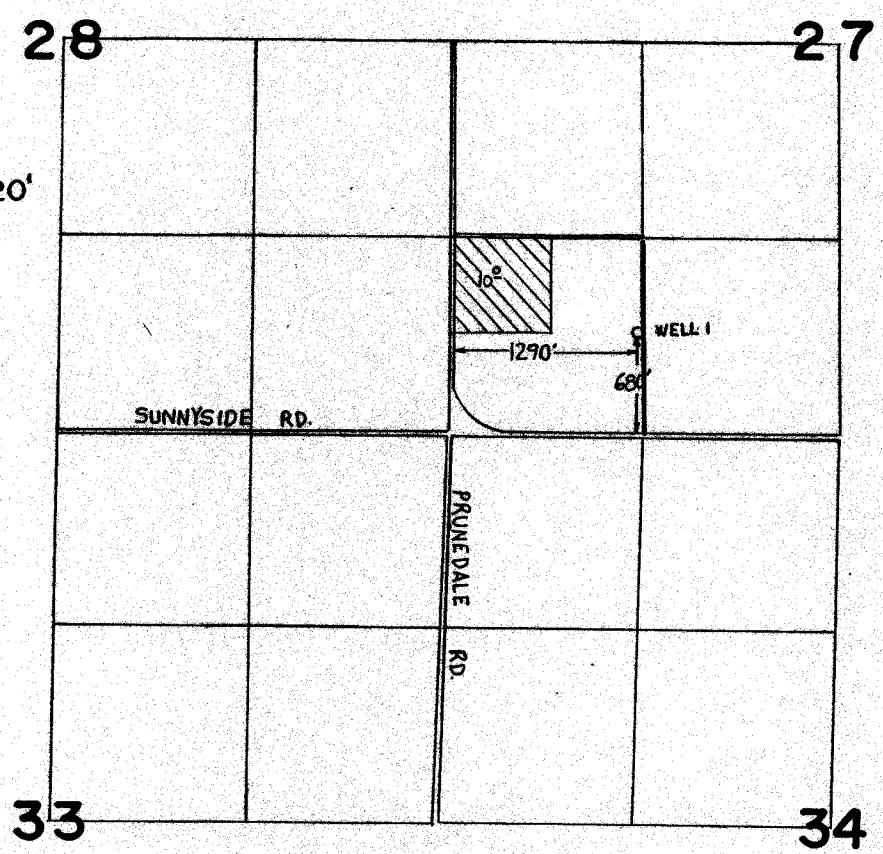


210131
LSB7B

T. 6 N., R. 35 E., W.M.

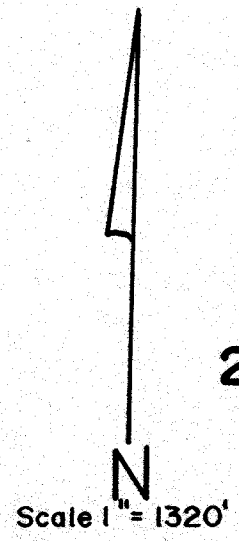

FINAL PROOF SURVEY UNDER

Application No. G.10813. Permit No. G.10131.....
IN NAME OF

WAYNE M. TRUMBULL

Surveyed May 8, 1986, by J. Sauter.....