



2-10679  
65879

# T.6N., R.35E., W.M.

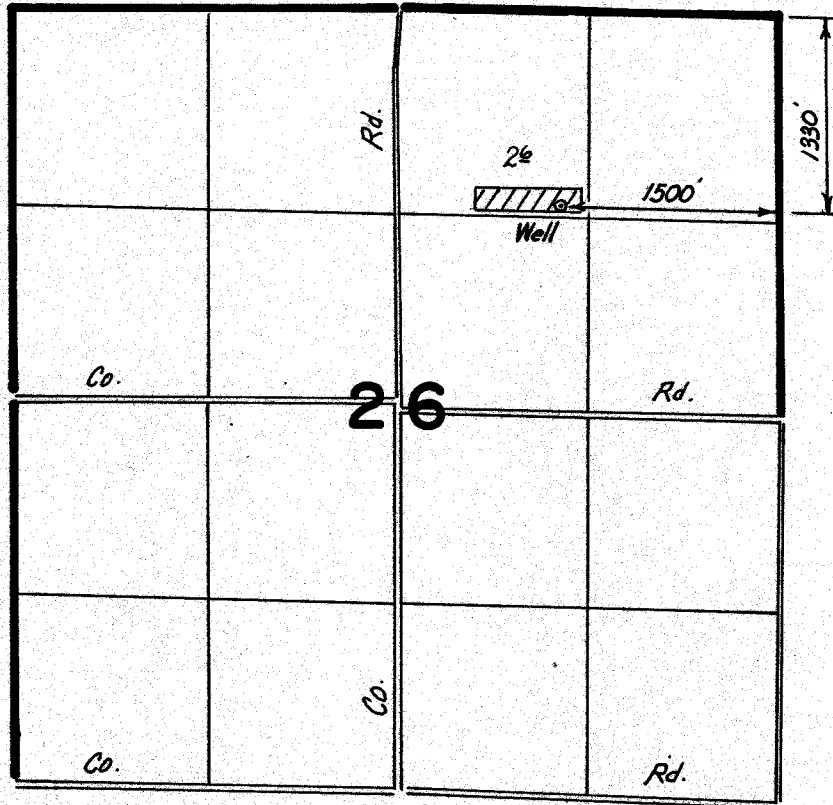

## FINAL PROOF SURVEY UNDER

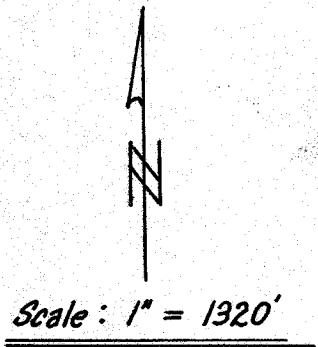

Application No. **G11567**. Permit No. **G10679**.  
IN NAME OF

**WAYNE TRUMBULL**

Surveyed 1-13 1988, by Vern Church