
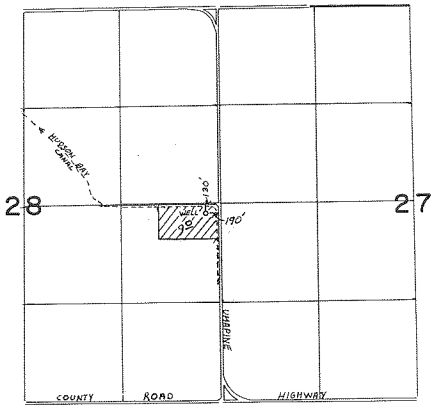


L10108
L5891

T. 6 N., R. 35 E., W. M.

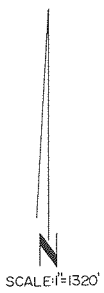

FINAL PROOF SURVEY
UNDER

Application No. G-10108... Permit No. G-10108....
IN NAME OF
RONALD A. RICHMAN

Surveyed MARCH 25, 1986, by J.E. Suter.....