


T. 28 S., R. 14 W., W.M.

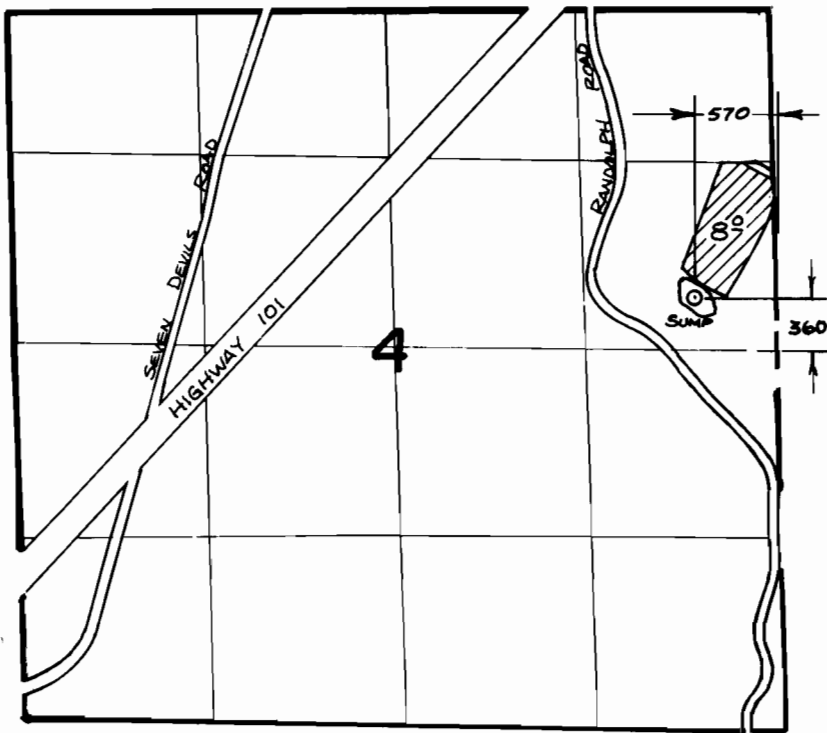

SCALE : 4" = 1 MILE

FINAL PROOF SURVEY UNDER

Application No. G.11468 Permit No. G.10591...
IN NAME OF

.....**MAX. CLAUSEN**.....

Surveyed ...8/.23... 19.88, by ...M..SCHMORDE...