


T.2S., R.2W., W.M.

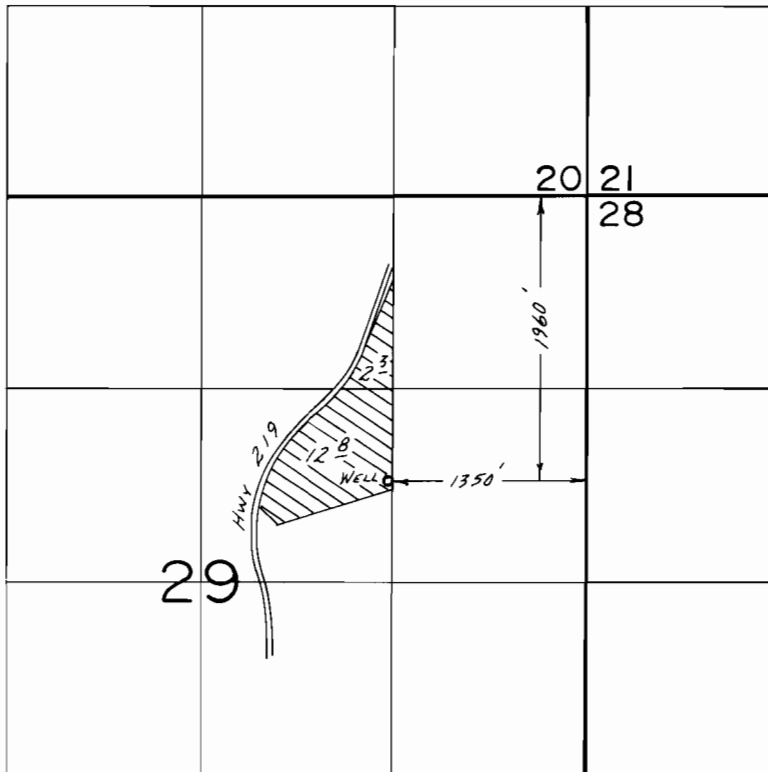

SCALE: 1" = 1320'

FINAL PROOF SURVEY
UNDER

Application No. G-11169. Permit No. G-10275....
IN NAME OF

.....NORMAN B. PETERSON.....

Surveyed Aug. 6.... 1986, by B.W. BISHOP.....

1/2/87
BWB