


T.24S., R.29E., W.M.

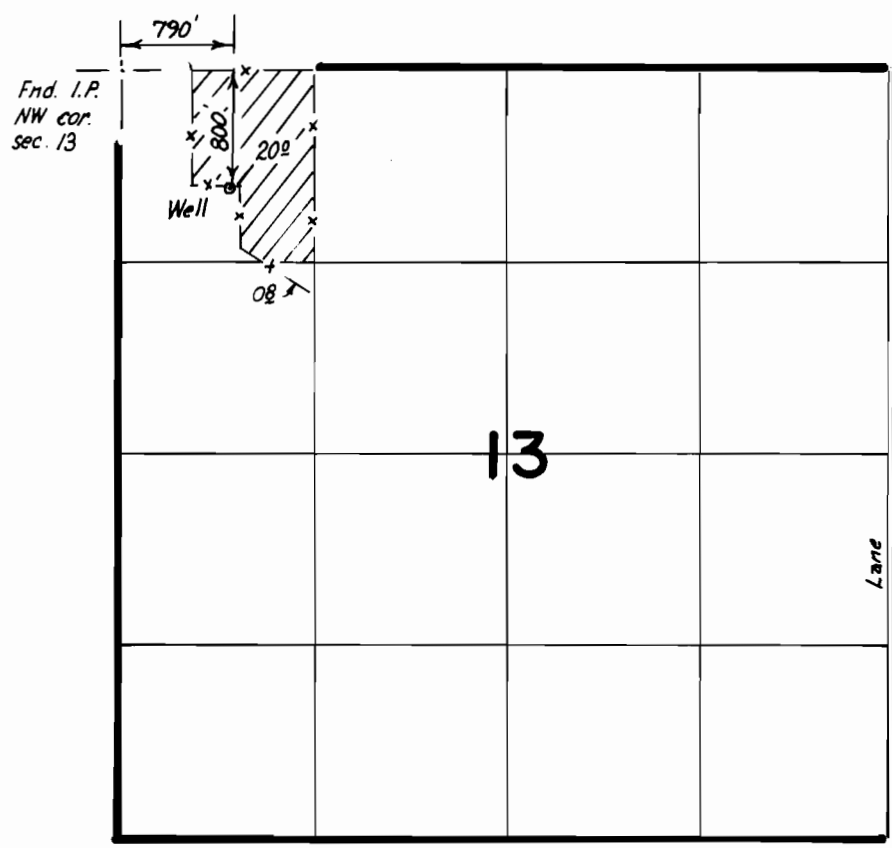

FINAL PROOF SURVEY

UNDER

Application No. G11621 Permit No. G10747
 IN NAME OF

.....JOHN WILLIAM WILSON.....

Surveyed 5-9..... 1988., by Sue James.....

