


6-10958  
65884  
DEC 12

# T.38S. R.9E. W.M. NE1/4 SECTION 32


29 28  
32 33



SCALE 1" = 400'

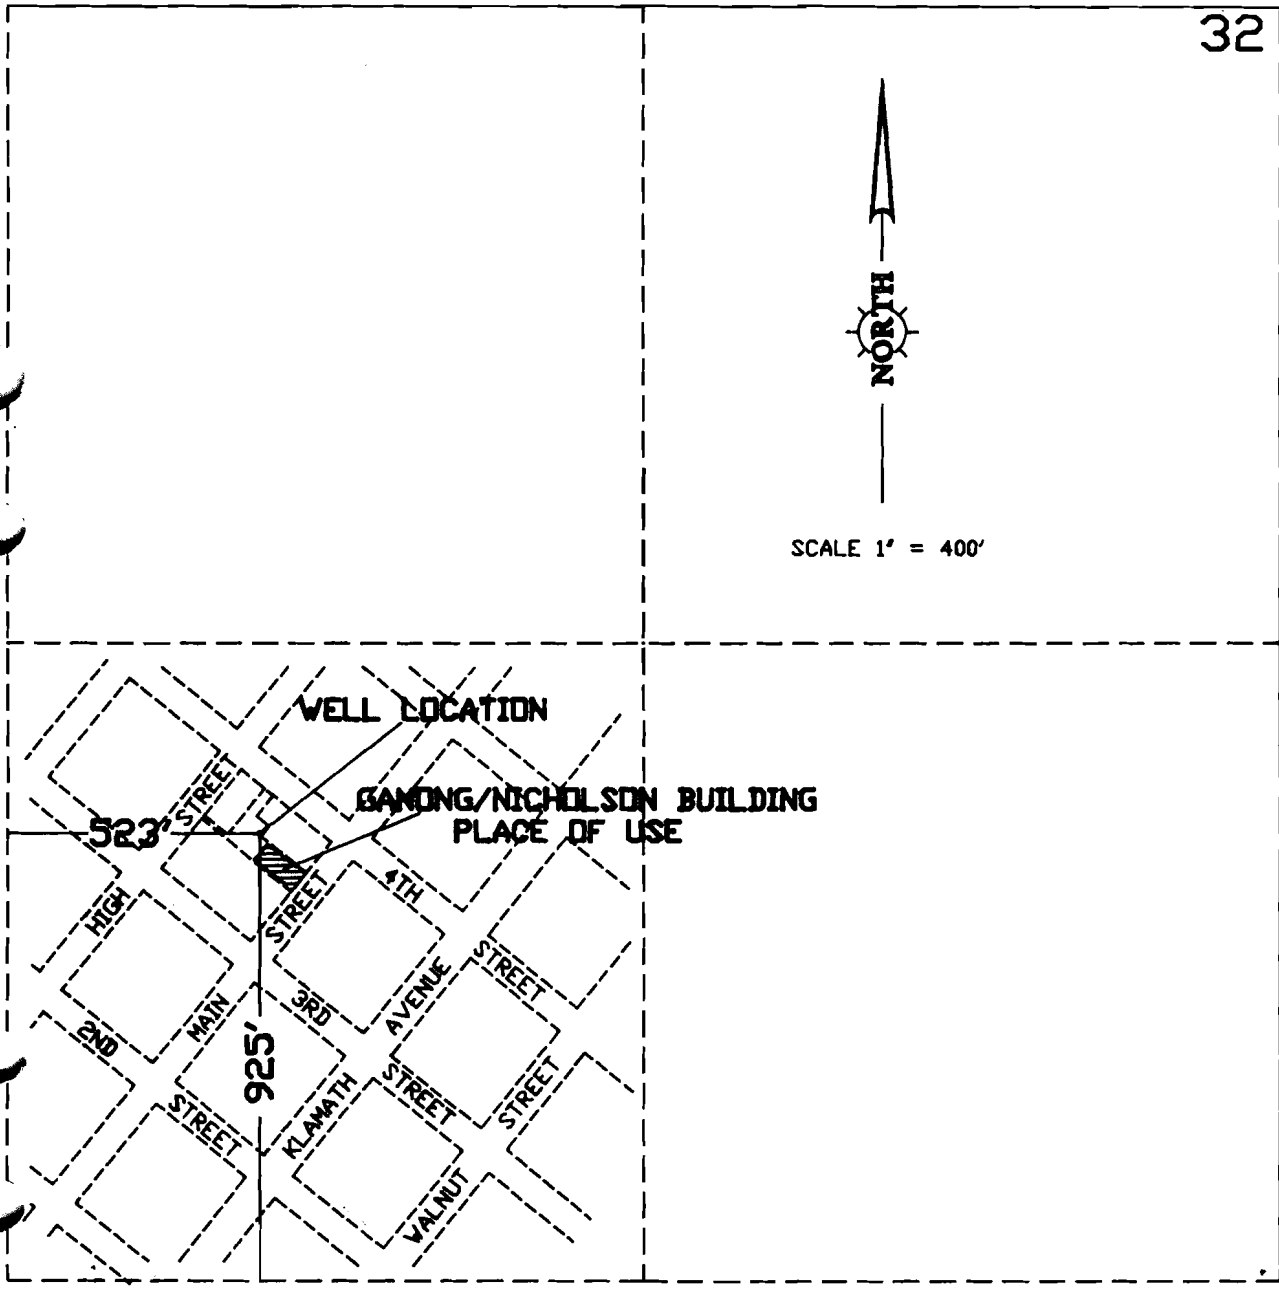

Alamoth River Valley

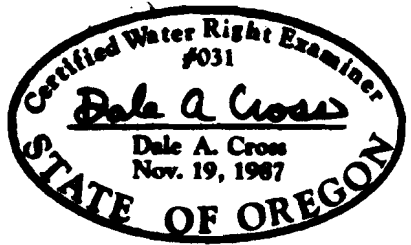

## FINAL PROOF SURVEY

UNDER

Application No. G-11900 Permit No. G-10958

IN THE NAME OF

**GANONG/NICHOLSON BLDG. INC.**

Surveyed October 29, 1990

THE PREPARATION OF THIS MAP WAS FOR THE PURPOSE OF IDENTIFYING THE LOCATION OF THE WATER RIGHT ONLY AND HAS NO INTENT TO PROVIDE DIMENSIONS OR LOCATIONS OF PROPERTY OWNERSHIP LINES.