
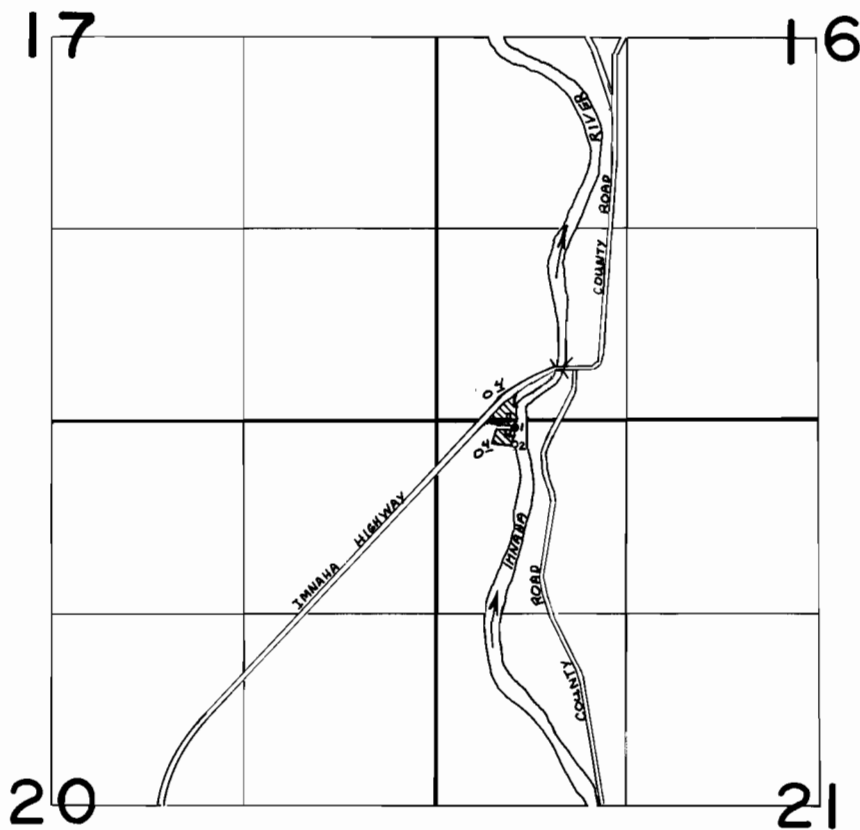


T. 1 N. R. 48 E. W. M.

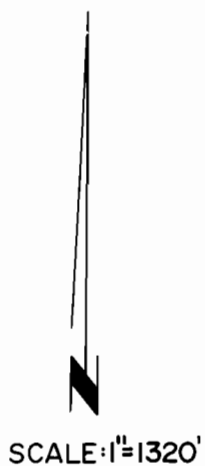

DIV.PT.1 LOCATED 50' S. AND 540' E. FROM SW. SEC. COR. SEC. 16
DIV.PT.2 LOCATED 160' S. AND 540' E. FROM SW. SEC. COR. SEC. 16

FINAL PROOF SURVEY UNDER

Application No. 57164... Permit No. 42934.....
IN NAME OF

W.D. MORGAN & LLOYD DOSS

Surveyed 8-7 1984, by V.L. CHURCH