
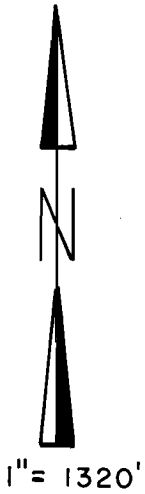


T. 18 S., R. 45 E., W.M.

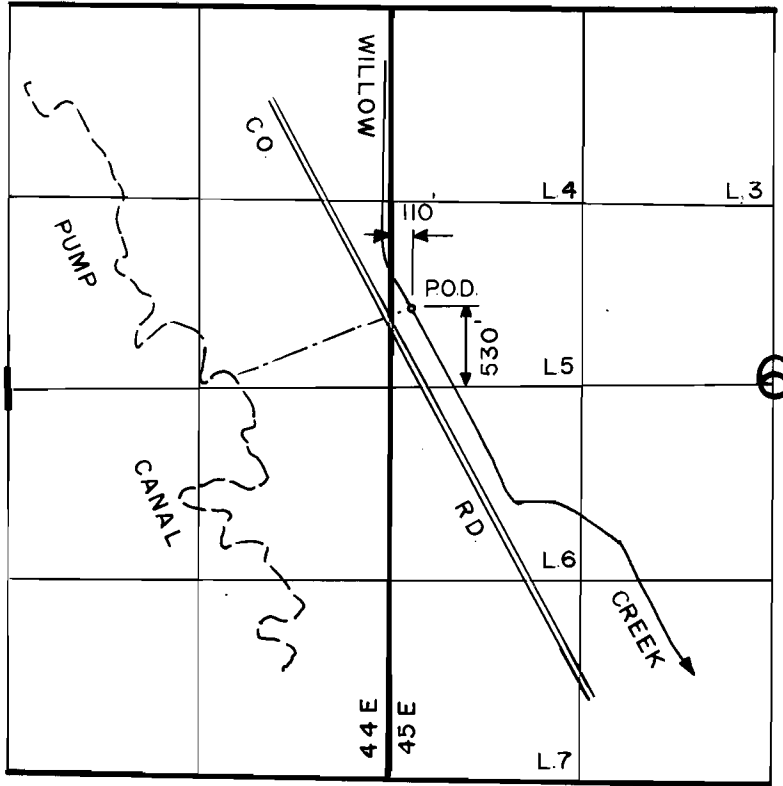

FINAL PROOF SURVEY
UNDER

Application No. 57274 Permit No. 43331
IN NAME OF

WARMSPRINGS IRRIGATION DISTRICT

Surveyed APRIL 15 1986, by L. TOLL

8-2-90 DSM
BBC-5N-49