


T.7S. R.38&4 W., W.M.

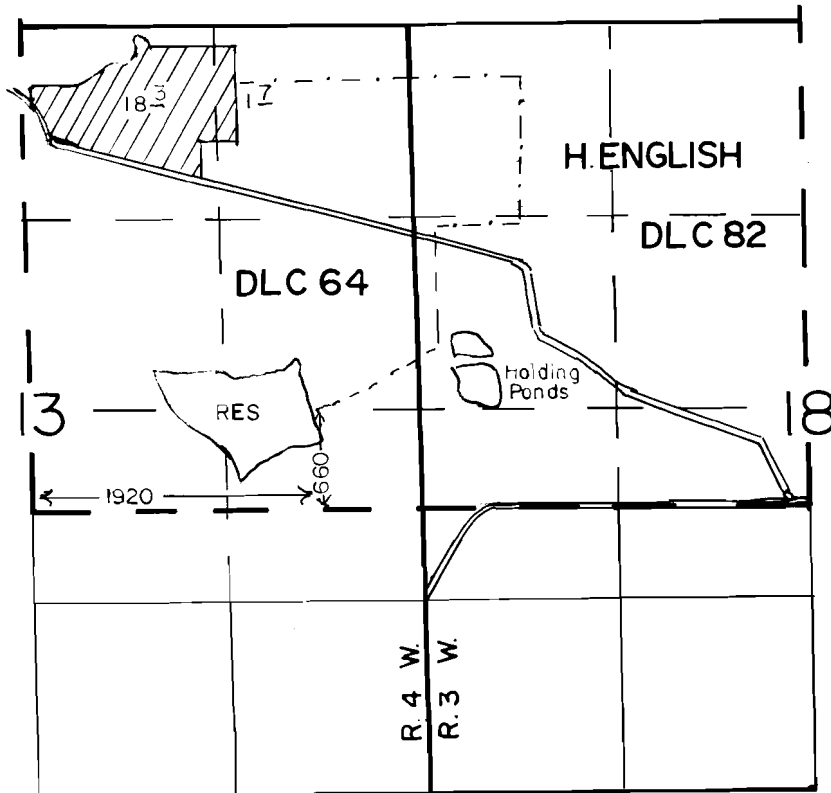

SCALE
1" = 1320'

FINAL PROOF SURVEY
UNDER

Application No. 57476 Permit No. 43242
IN NAME OF

DAVID WAYNE SIMMONS

Surveyed AUG. 17... 1984, by J. WOODROOF