


T.13S.,R.30E.,W.M.

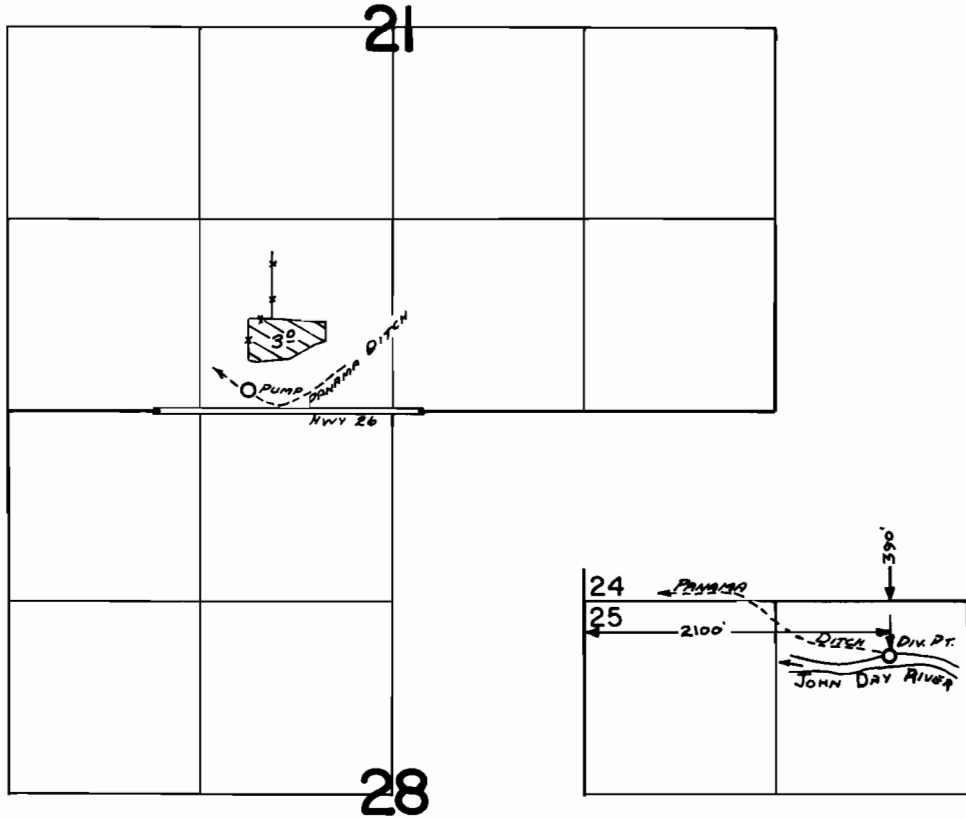

FINAL PROOF SURVEY
UNDER

Application No. .57592... Permit No. .43397.....
IN NAME OF

.....**MT. VERNON SCHOOL**.....

Surveyed .Aug..25... 19.83., by ..R..W..Cettel... ..