


T. 4N., R. 28E., W. M.

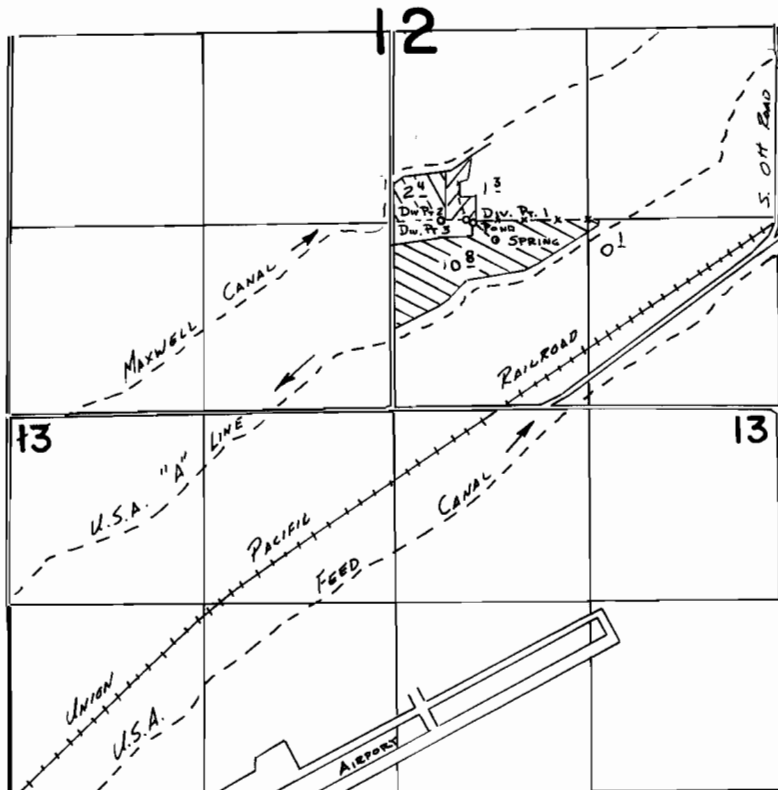

SCALE: 1" = 1320'

SPRING Loc: 1150' N. & 700' E. FROM S 1/4 COR. SECTION 12  
 Div. Pr. 1 Loc: 1320' N. & 500' E. FROM S 1/4 COR. SECTION 12  
 Div. Pr. 2 & 3 Loc: 1320' N. & 330' E. FROM S 1/4 COR. SECTION 12

HUSTON     
  SMITH     
  FORDICE

**FINAL PROOF SURVEY**  
 UNDER

Application No. **57955**. Permit No. **43581**....  
 IN NAME OF

.....  
 Surveyed Jan. 15, 1985, by V. L. Church.....