


T.39 S., R.14 W., W.M.

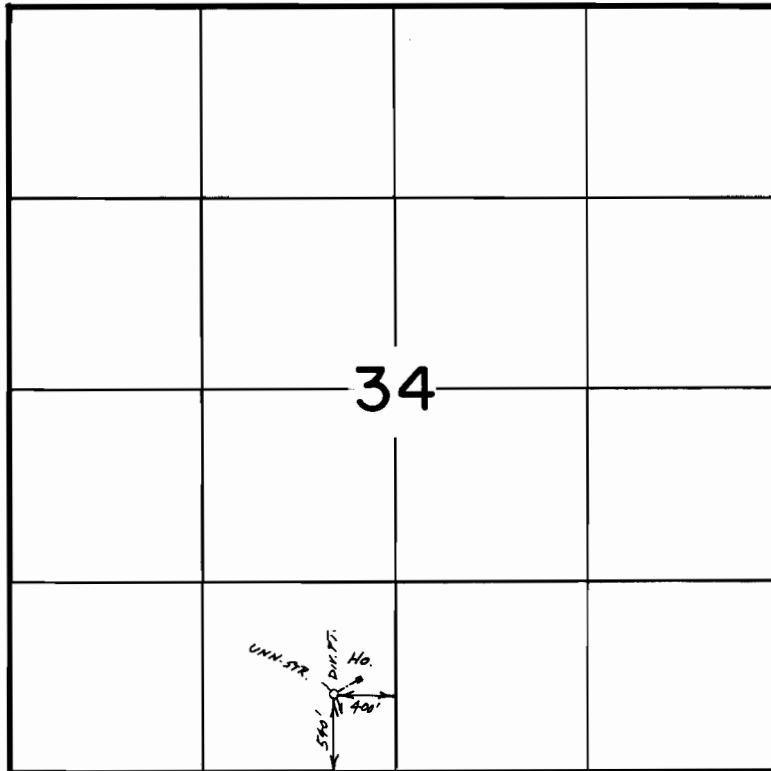

Scale 1"=1320'

FINAL PROOF SURVEY
UNDER

Application No. 60791... Permit No. 46194.....
IN NAME OF

..... RENEE NEWMAN

Surveyed Oct. 10, 1985, by J.M. SCHMORDE
Oct. 9, 1988, B.S. JAMES