


T.2N., R.48E., W.M.

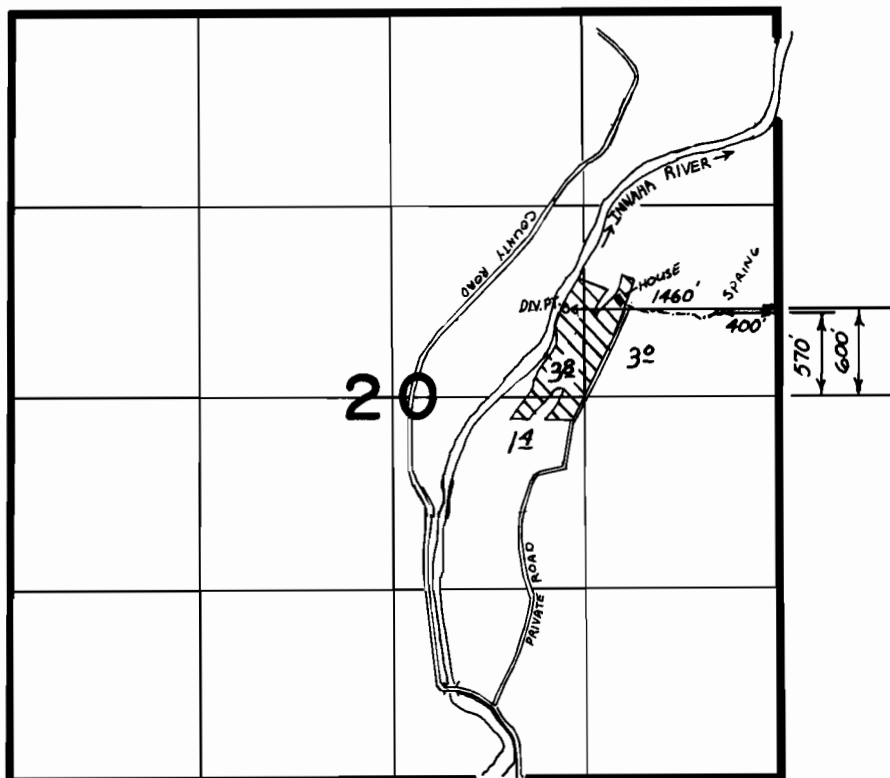

SCALE: 1"=1320'



FINAL PROOF SURVEY
UNDER

Application No. 60847... Permit No. 46059.....

IN NAME OF

KENNETH E. STEIN

Surveyed AUG. 7..... 1985., by V.L. CHURCH.....