


T. 27 S., R. 6 W., W.M.

SECTION 30

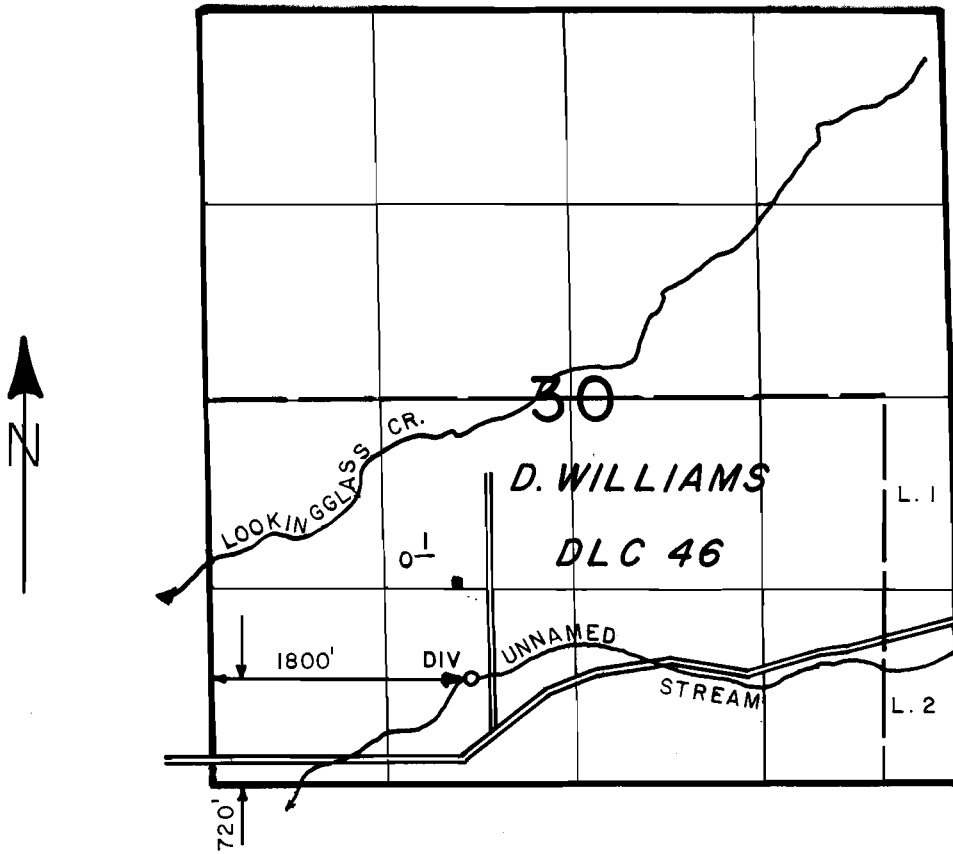

SCALE: 4" = 1 MILE

FINAL PROOF SURVEY UNDER

Application No. 63852... Permit No. 47264
IN NAME OF

RALPH HANLEY

Surveyed OCT. 7... 1986, by J. R. KAUPPILA.