


T. 26 S., R. 6 W. WM.

SEC. 19

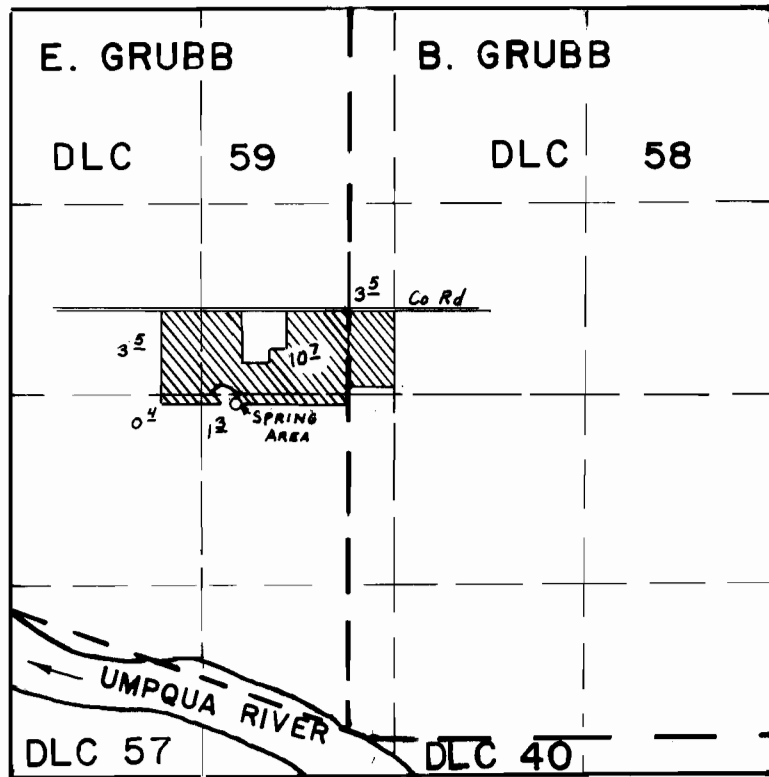

SCALE  
1" = 1320'

DIV. PT. LOC. 50'S. & 1550' E. OF W. 1/4 COR. SEC. 19

**FINAL PROOF SURVEY**  
UNDER

Application No. 64925. Permit No. 47488.....  
IN NAME OF

**DON R. YOUNG**.....

Surveyed **MAY 4, 1984**, by **L. CASHION**.....

4/18/85  
BTR-1HH-53

JEC  
PGT