


T. 30 S., R. 6 W., W. M.

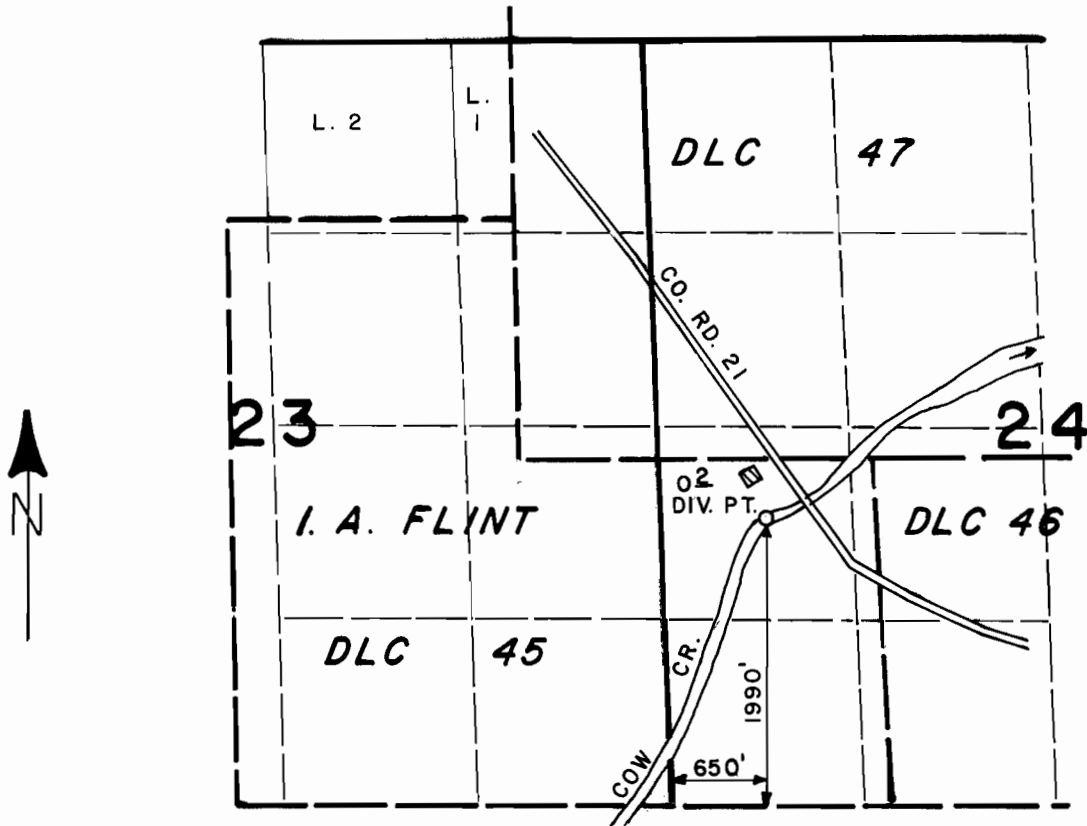

SCALE: 4" = 1 MILE

FINAL PROOF SURVEY
UNDER

Application No. 64948.. Permit No. 47717.....
IN NAME OF

CLINTON E. ATHERTON

Surveyed JUNE 26, 1984., by L. E. CASHION...