


R 47817
65901

T. 9S., R. 21E., W.M.

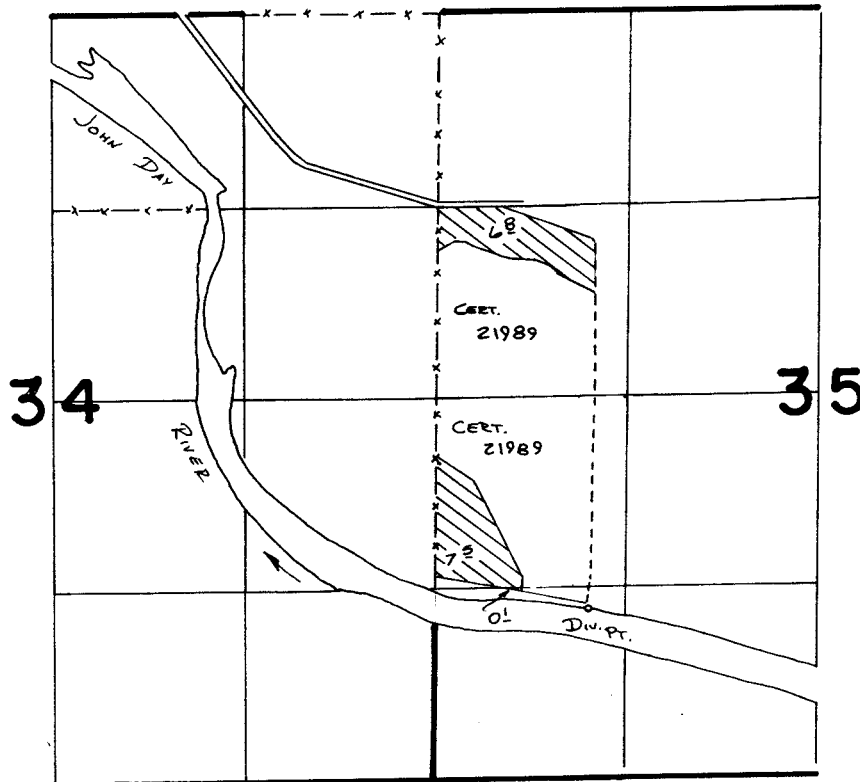

SCALE: 1" = 1320'

Div. Pt. Loc: 1150' N. & 1050' E FROM SW COR SEC 35

FINAL PROOF SURVEY UNDER

Application No. **65098** Permit No. **47817**.....
IN NAME OF

DAVID L. WOOLFOLK.....

Surveyed **4-22**..... **1986**., by **V. L. Church**.....

18CR

VLC