


T.27S., R.6W., W.M.

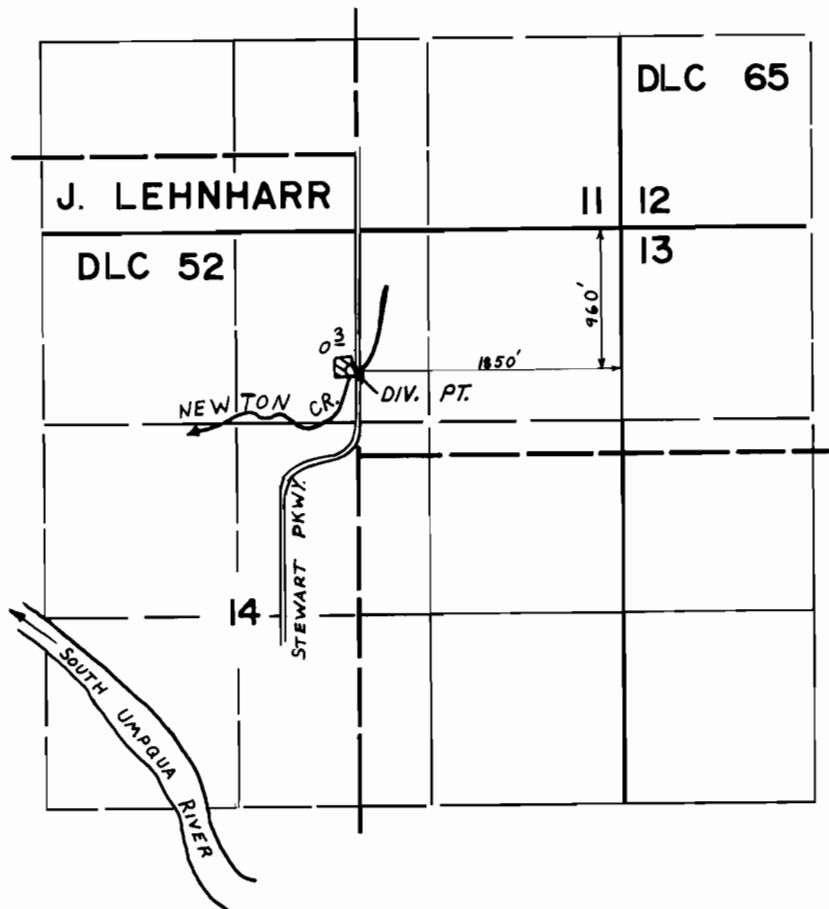

SCALE: 4" = 1 mile

FINAL PROOF SURVEY
UNDER

Application No. 65180.. Permit No. 47587.....
IN NAME OF

.....GILBERT G. MURRAY.....

Surveyed DEC.....5, 1983, by *J.E. Cashman*