


20684

**T.24S., R.7W., W.M.
SECTION 13**

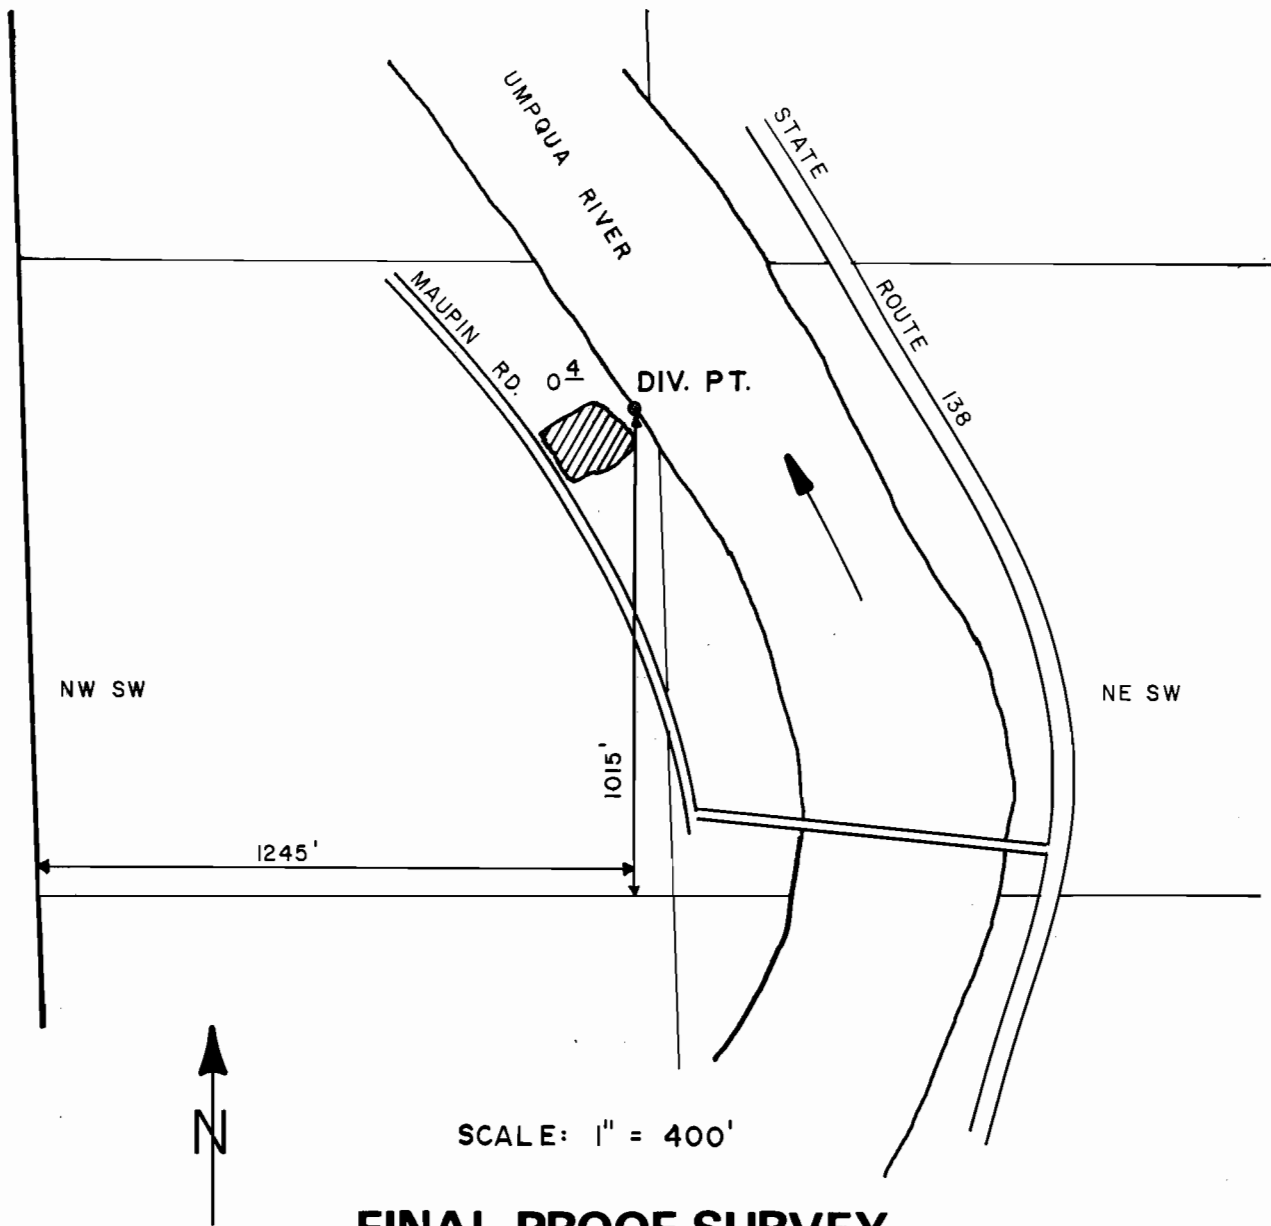

**FINAL PROOF SURVEY
UNDER**

Application No. 66272 Permit No. 48058
IN NAME OF

VICTOR J. GALLON

Surveyed AUG. 11 1986, by J. M. SCHMORDE