


T.15S. R.58&6W. W.M.

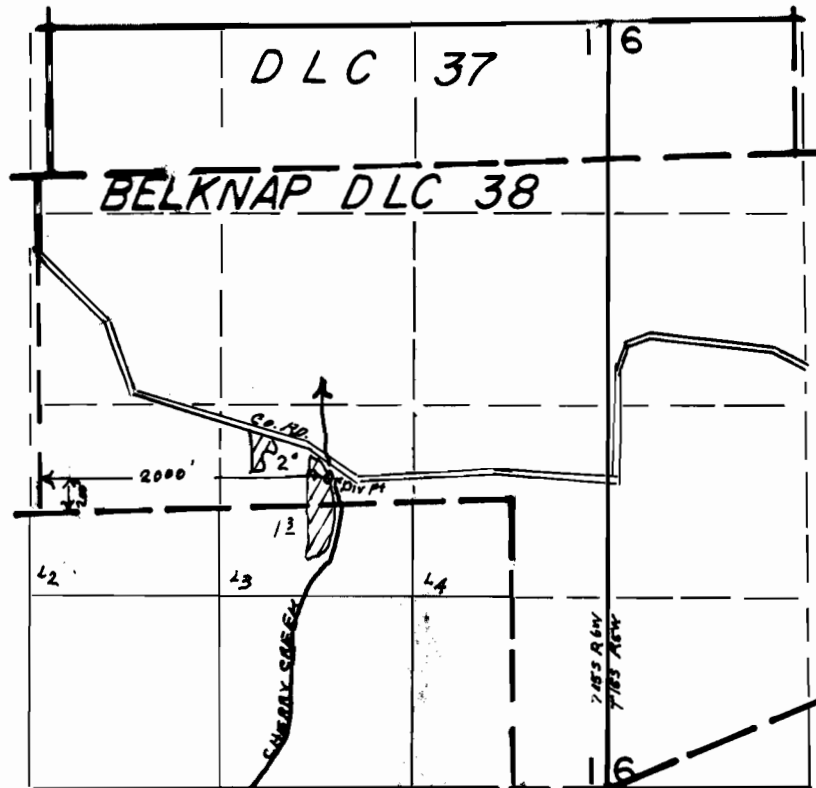

SCALE: 1" = 1320'

# **FINAL PROOF SURVEY** UNDER

Application No. 66699... Permit No. 48105.....  
IN NAME OF

.....EMIL GEORGE SITKEI.....

Surveyed OCT. 27.. 1987., by I.M. WARREN.....