


# T.24S., R.7W., W.M. SECTION 13

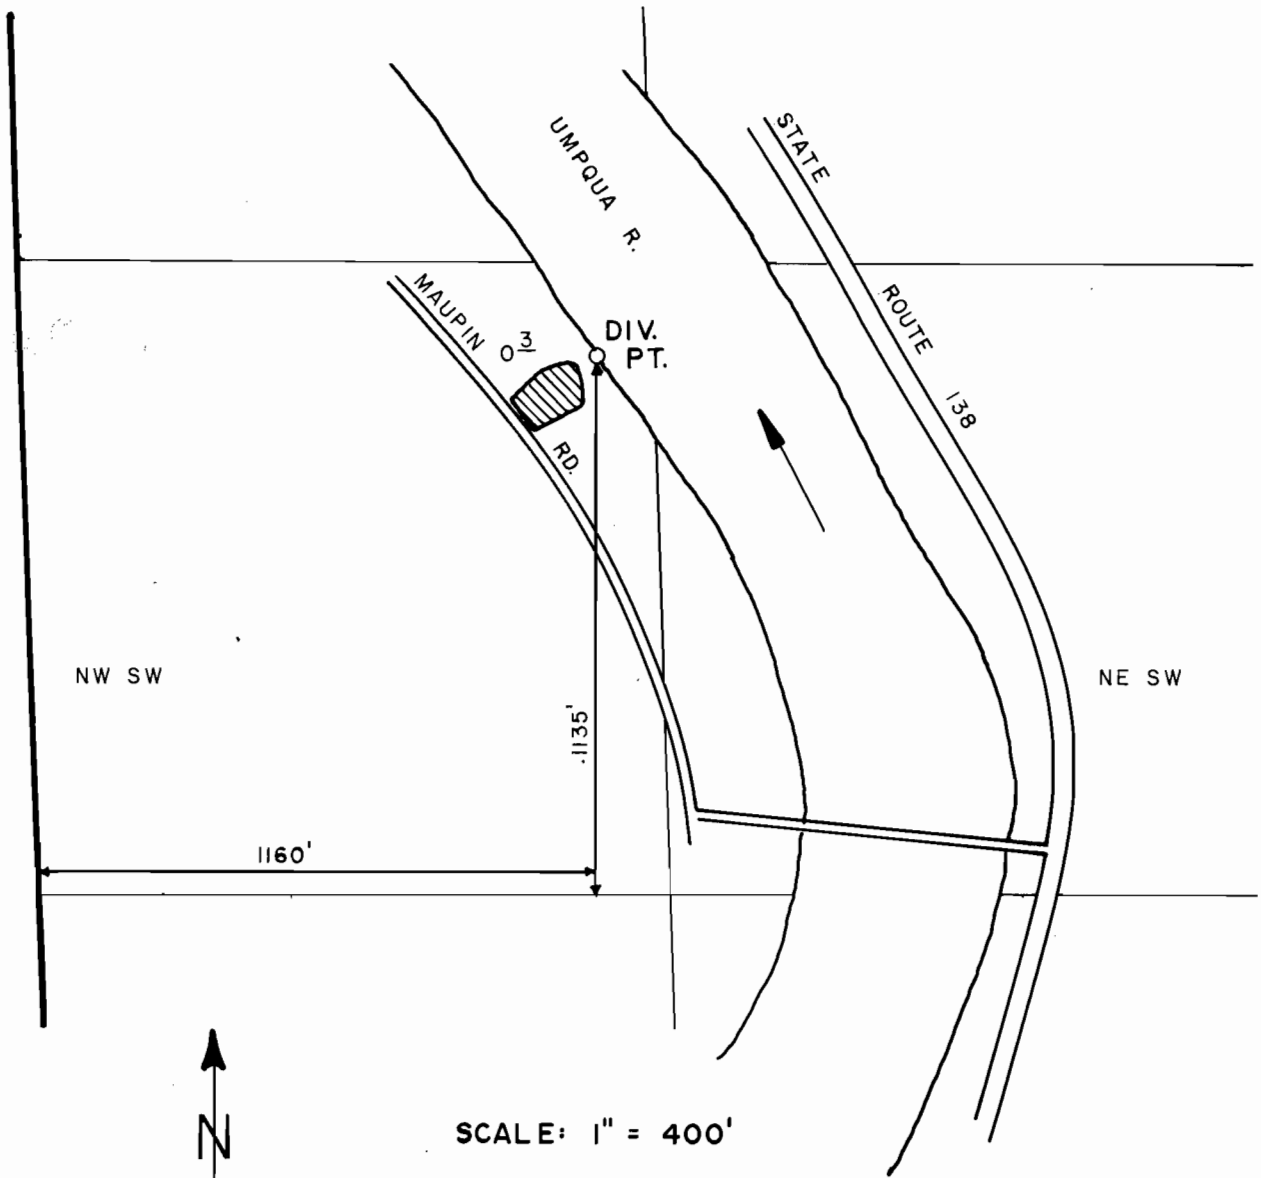

SCALE: 1" = 400'

## FINAL PROOF SURVEY UNDER

Application No. 67338 Permit No. 48187  
IN NAME OF

MARVIN H. BILDERBACK

Surveyed AUG. 7, 1986, by J.M. SCHMORDE