


# T. 30S., R. 3 and 4 W., W.M.

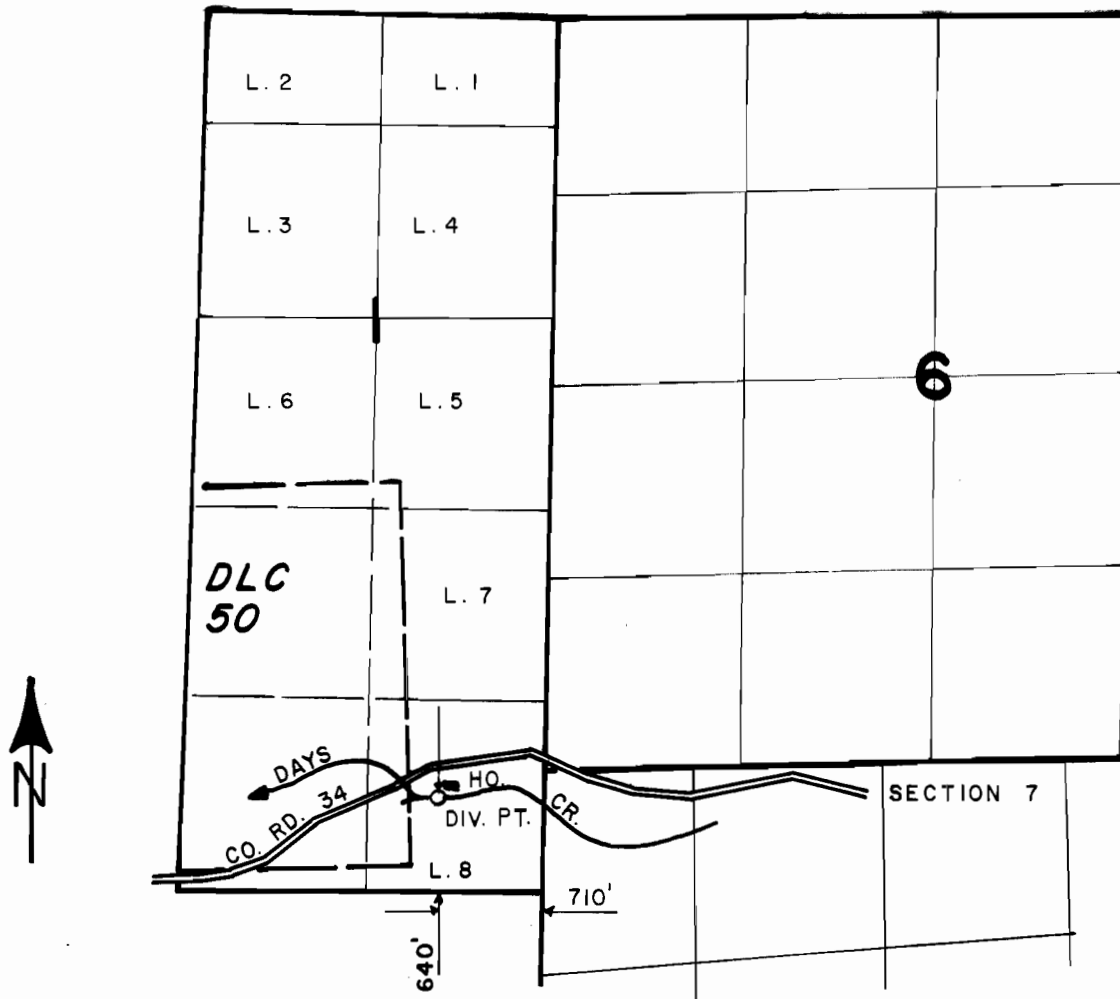

SCALE: 4" = 1 MILE  
**FINAL PROOF SURVEY**  
 UNDER

Application No. 68482 Permit No. 49660  
 IN NAME OF

GERALD DEAN BLIVEN

Surveyed AUG. 11, 1987, by J.M. SCHMORDE