


T. 25 S., R 4 W., W. M.

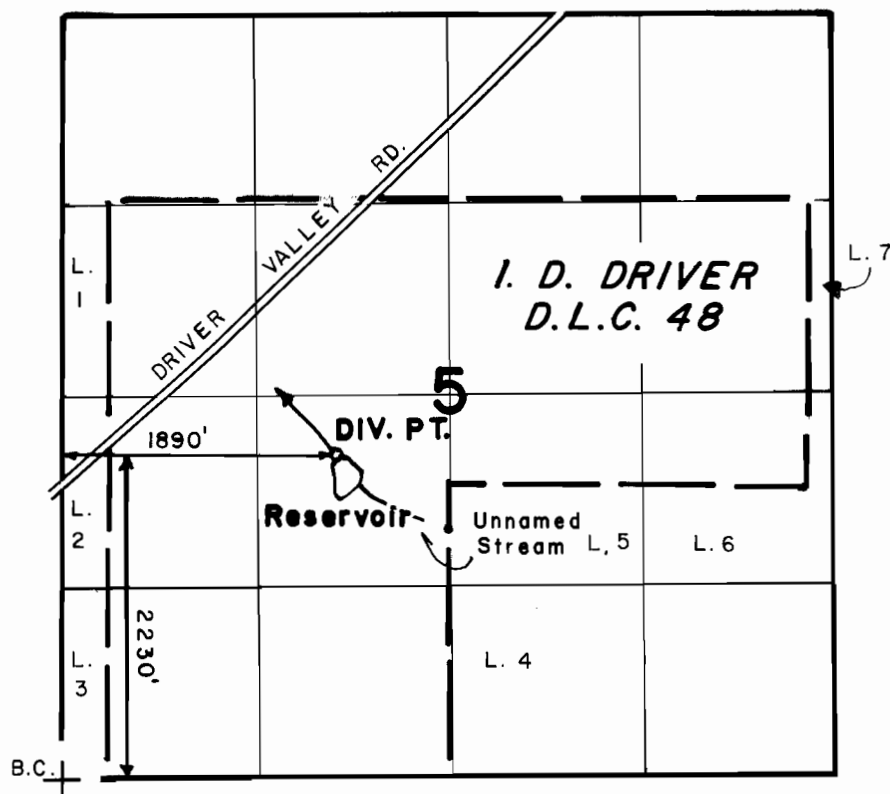

SCALE: 4" = 1 MILE

FINAL PROOF SURVEY
UNDER

Application No. R-68542 Permit No. R-10610
IN NAME OF

William Brownsberger, A.K.A. Brownsberger Ranch

Surveyed **JUNE 9 1987**, by **J. M. SHMORDE**