


T. 30 S., R. 4 W., W. M.

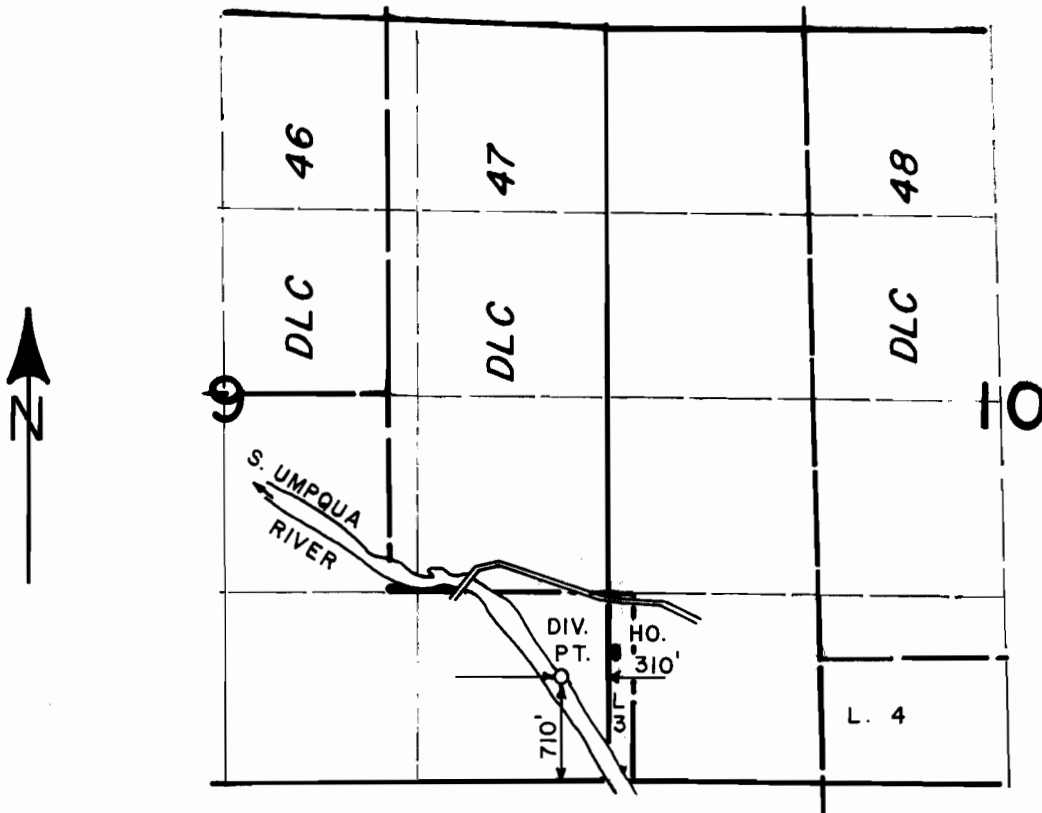

SCALE: 4" = 1 MILE

FINAL PROOF SURVEY
UNDER

Application No. 68640... Permit No. 49625.....
IN NAME OF

JOHN E. PRITCHARD AND BERLVA L. PRITCHARD

Surveyed AUG. 11... 19.87, by J. M. SCHMORDE.