


T.3S., R.40E., W.M.

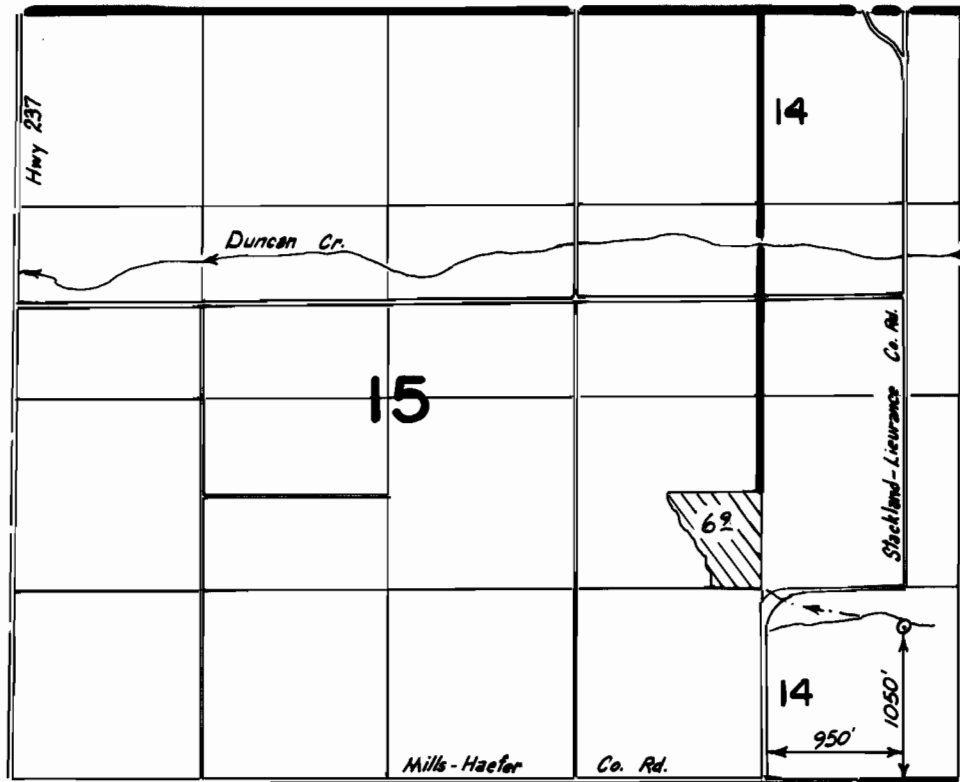

Scale : 1" = 1320'

FINAL PROOF SURVEY UNDER

Application No. **68779**. Permit No. **49921**.....
IN NAME OF

ROBERT F. HILL

Surveyed *11-2*..... 19*87*., by *Vern. Church*.....