


T. 3 S., R. 2 E., W.M.

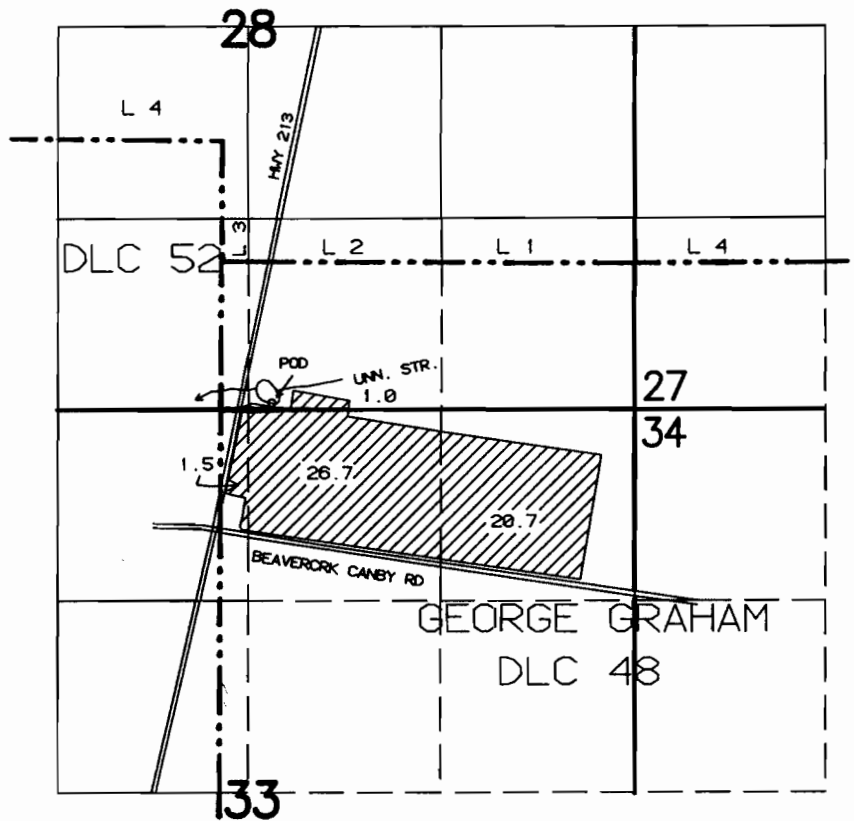

1" = 1320 FT

POD IS LOCATED 40 FT N AND 160 FT
E FROM THE S 1/4 CORNER SECTION 28

FINAL PROOF SURVEY
UNDER

Application No.: 68796 Permit No.: 49922
IN THE NAME OF

ELDON C. EVANS

Surveyed: AUG. 31, 1987

By: T. M. WARREN

RWK

41005 278 177B