


# T.2N., R.12E., W.M.

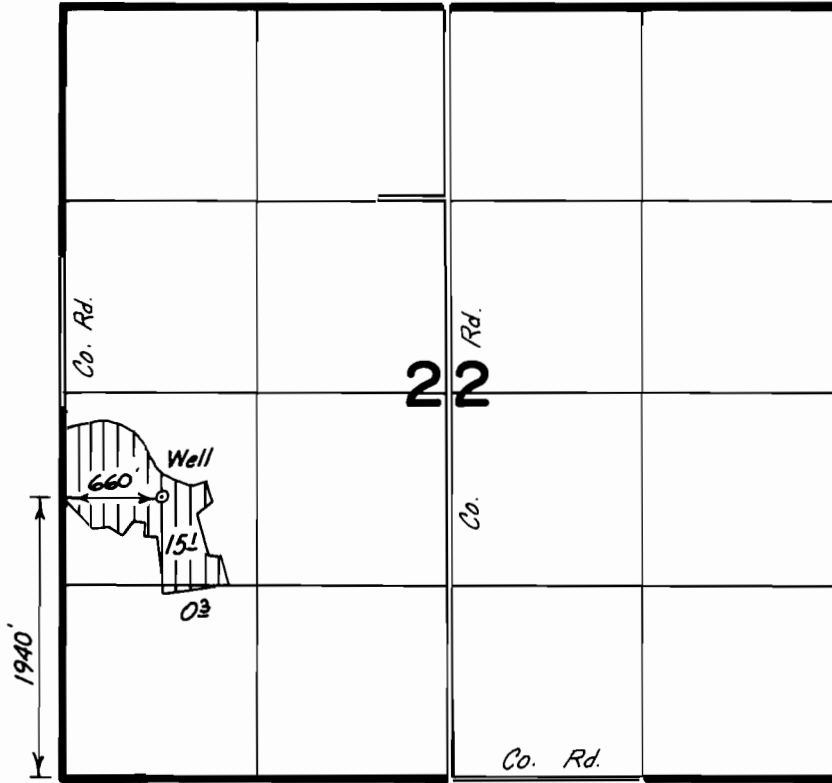

## FINAL PROOF SURVEY UNDER

Application No. **G6683** Permit No. **G6235**...  
IN NAME OF

.....**LAWRENCE F. BLACK**.....

Surveyed ...**11-17**... 19.87., by ..**Vern Church**...



Scale: 1" = 1320'