


T.8S.,R.2W., W.M.

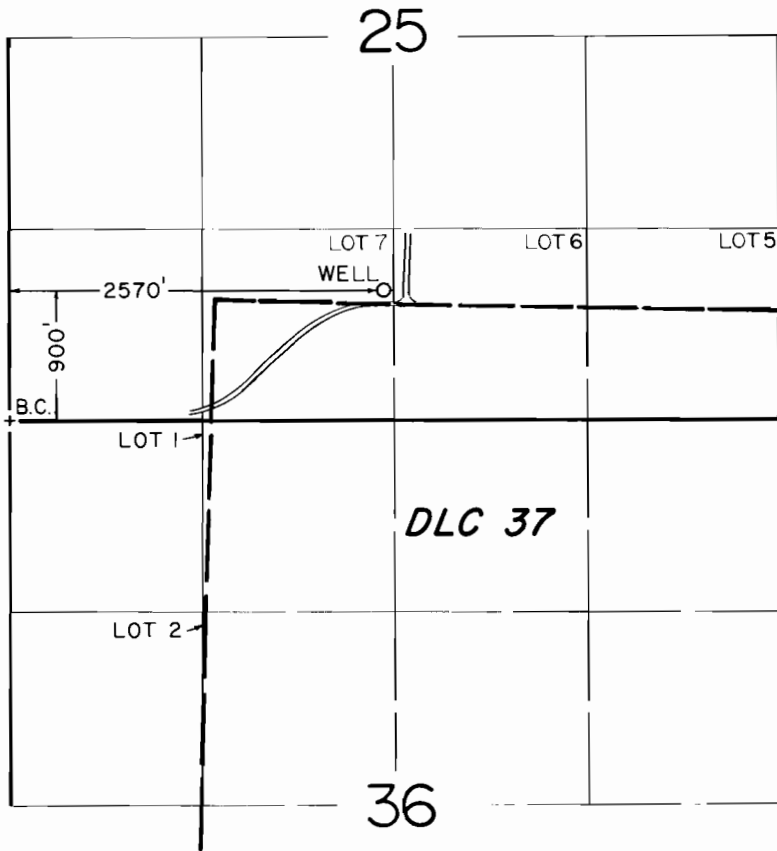

SCALE: 1" = 1320

FINAL PROOF SURVEY
UNDER

Application No. G-6861 Permit No. G-6400
IN NAME OF

CITY OF AUMSVILLE

Surveyed AUG. 26 1985, by B.W. BISHOP

Revised: 6-27-90