


T. 33 S., R. 18 E., W.M.

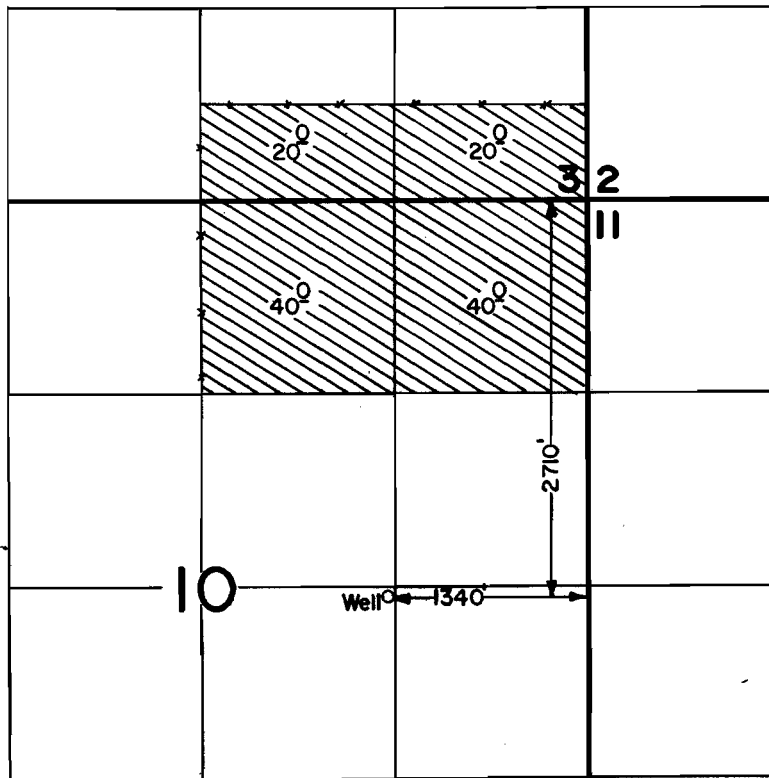

Scale: 1" = 1320'

FINAL PROOF SURVEY
UNDERApplication No. G-7303. Permit No. G-7643.....
IN NAME OF**ALAN G. & V. GINGER WITHERS**

Surveyed Oct...15.... 1985, by J.T. Warren.....