



T.9S., R.40E., W.M.

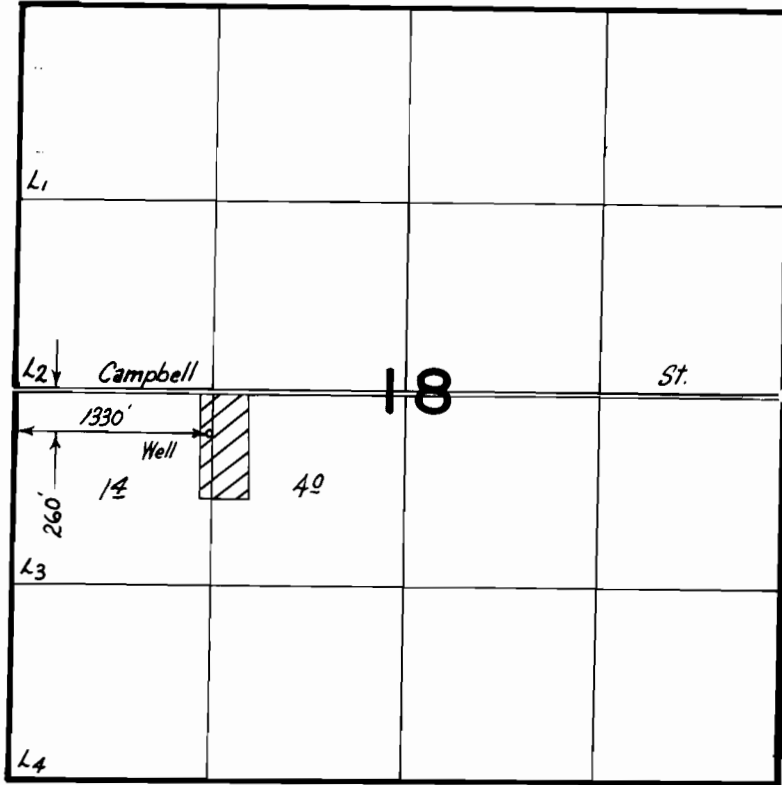

FINAL PROOF SURVEY UNDER

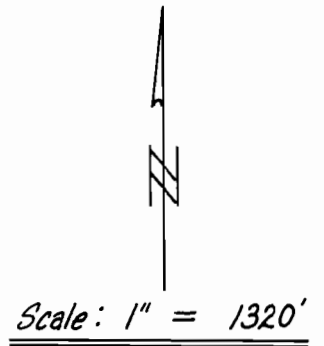

Application No. **G7326** Permit No. **G6766**
IN NAME OF

DeFOREST M. BALLARD

Surveyed 6-2 1987, by Vern Church