


T. 16S., R. 43E., W. M.

16

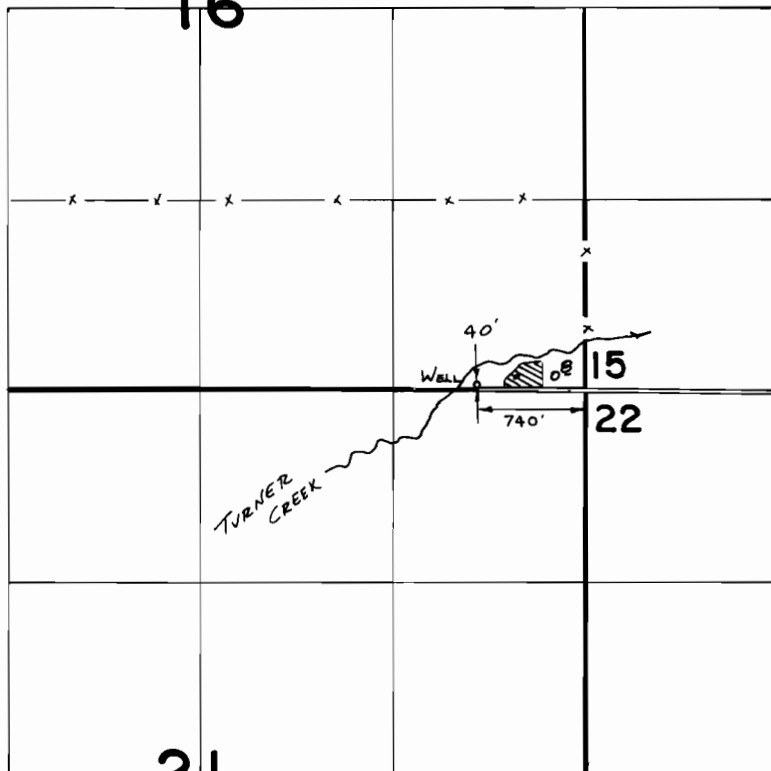

SCALE 1"=1320'

FINAL PROOF SURVEY
UNDER

Application No. **G7341** Permit No. **G6774**
IN NAME OF

ELEANOR L. SHORT

Surveyed **6-12-1986** by **V.L. CHURCH**