


# T.4 1S., R.13 W., W.M.

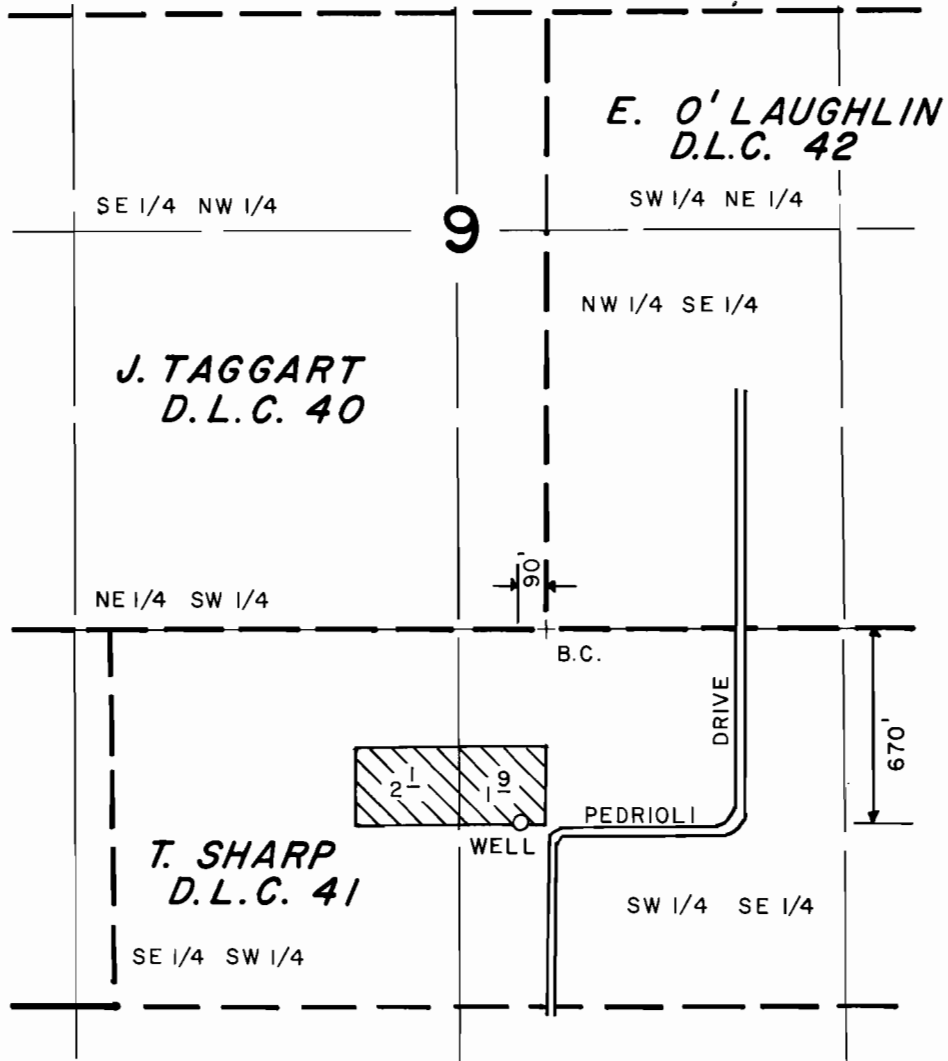

SCALE: 8" = 1 MILE

## FINAL PROOF SURVEY UNDER

Application No. G-7425 Permit No. G-7086  
IN NAME OF

GERALD E. & JUNE PENTER

Surveyed APRIL 9 1985, by L. E. CASHION