


T. 4S., R. 26E., W.M.

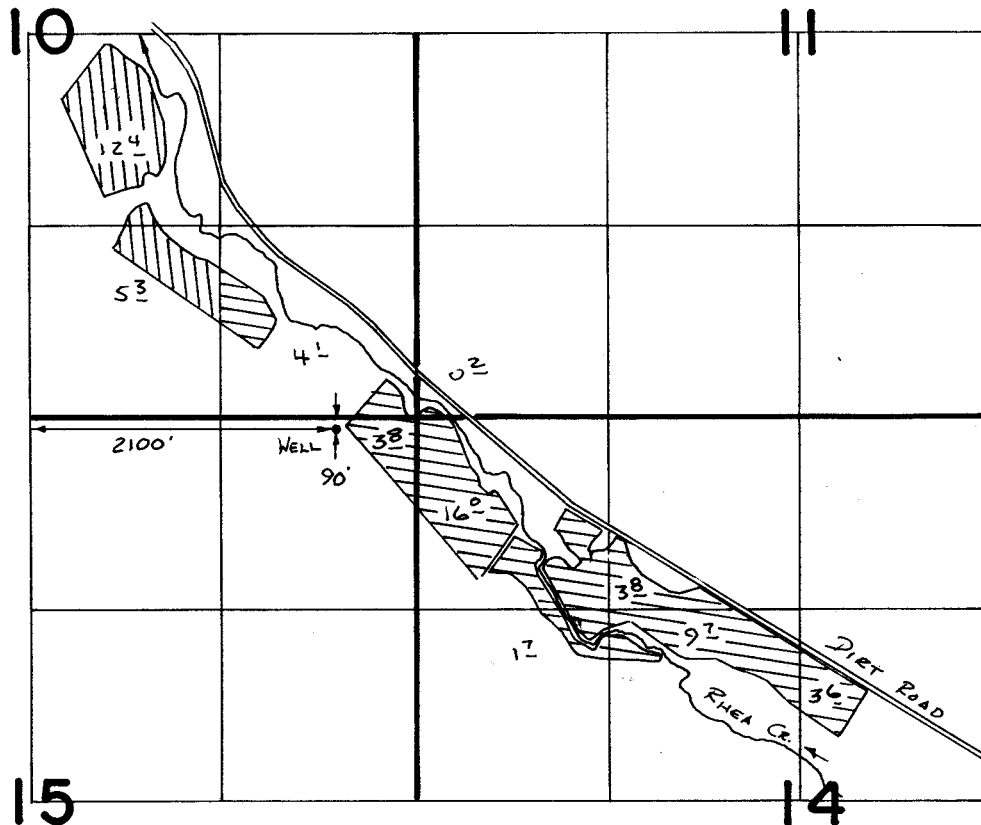

PRIM.



SUPPL.

FINAL PROOF SURVEY UNDER

SCALE 1" = 1320'

Application No. **G:7486** Permit No. **G:7261**...
IN NAME OF

.....**SHIRLEY**.....**RUGG**.....

Surveyed **12-21**..... **1987**., by **V.L. Church**.....