


T.15S. R.10E. W.M.

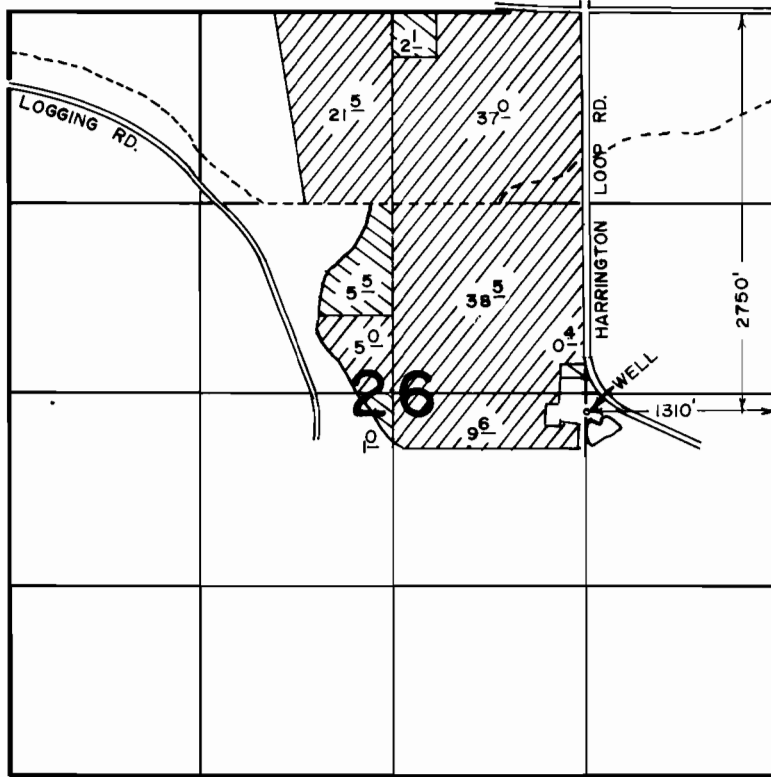

FINAL PROOF SURVEY UNDER

Application No. G-7621.. Permit No. G-7092.....
IN NAME OF

.....CHARLES R. TOPPING.....

Surveyed MAY 14 1980., by L.H. NUNN.....