


T.6S., R.1W., W. M.

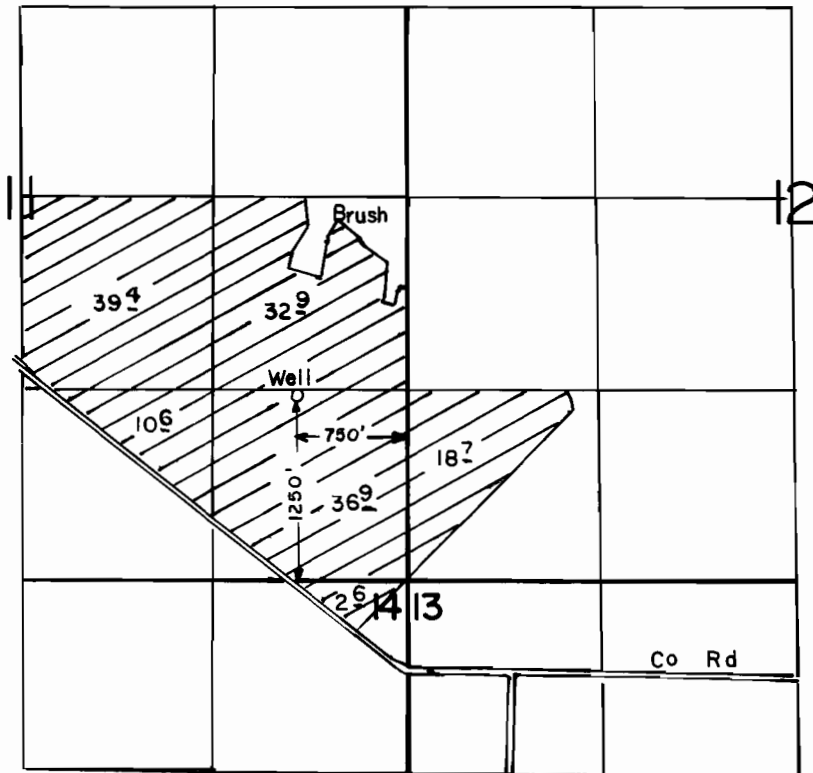

SCALE: 1" = 1320'

**FINAL PROOF SURVEY
UNDER**

Application No. G-8064. Permit No. G-7719....
IN NAME OF

..... MT. ANGEL ABBEY

Surveyed OCT. 2... 1979., by C.R. RODRIGUEZ.