


T.25S.,R.31E.,W.M

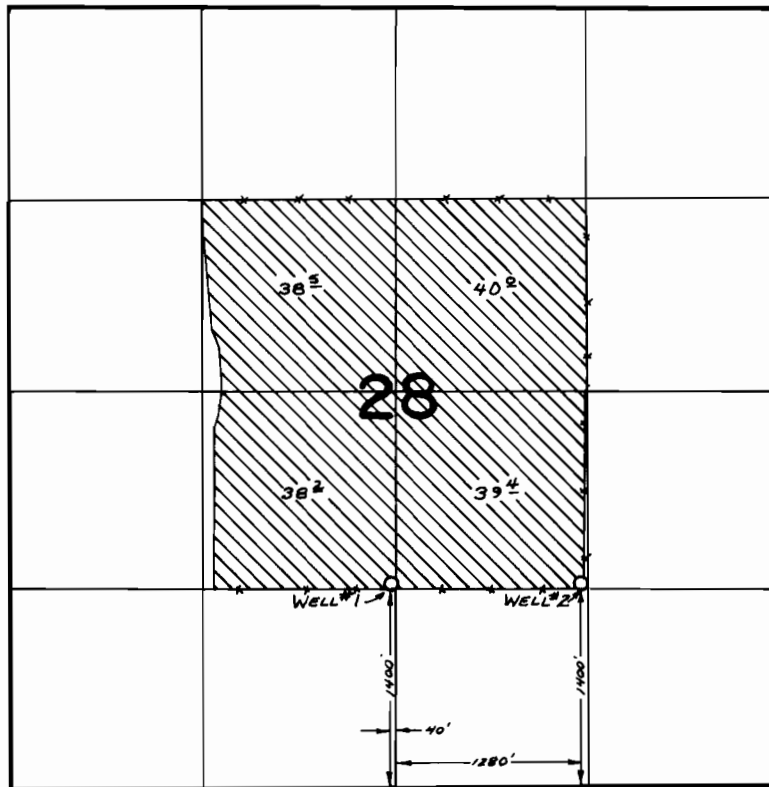

FINAL PROOF SURVEY UNDER

Application No. G-8500 Permit No. G-7990
IN NAME OF

MIKE AND JOHNA WILLIAMS

Surveyed OCT. 6. 1981, by L. T. OLL