



# T. 6S., R. 38E., W.M.

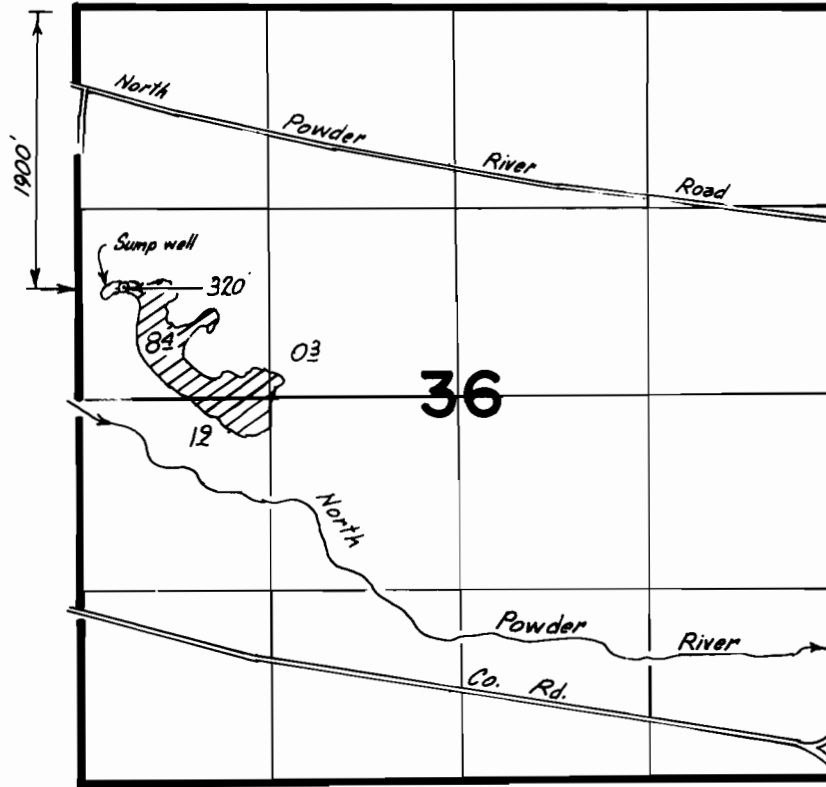

## FINAL PROOF SURVEY UNDER

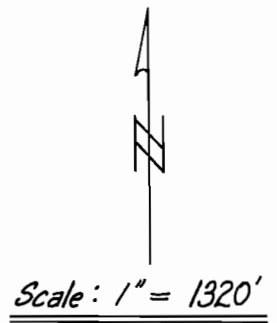

Application No. G-8600 Permit No. G-7978...  
IN NAME OF

**LULA A. CANTRELL & WILLIAM J. CANTRELL**

Surveyed 6-4 1987, by Vern Church...