


T. 2N., R. 18E., W. M.

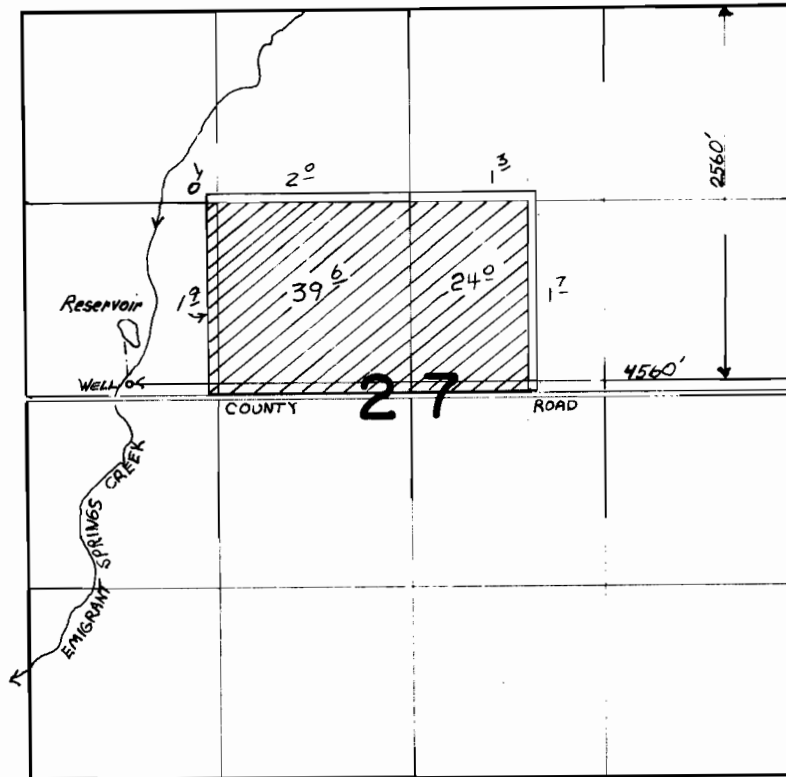

FINAL PROOF SURVEY
UNDER

Application No. G-8637 Permit No. G-7963
IN NAME OF

DEWEY J. THOMAS

Surveyed May 8, 1985, by V.L. CHURCH