
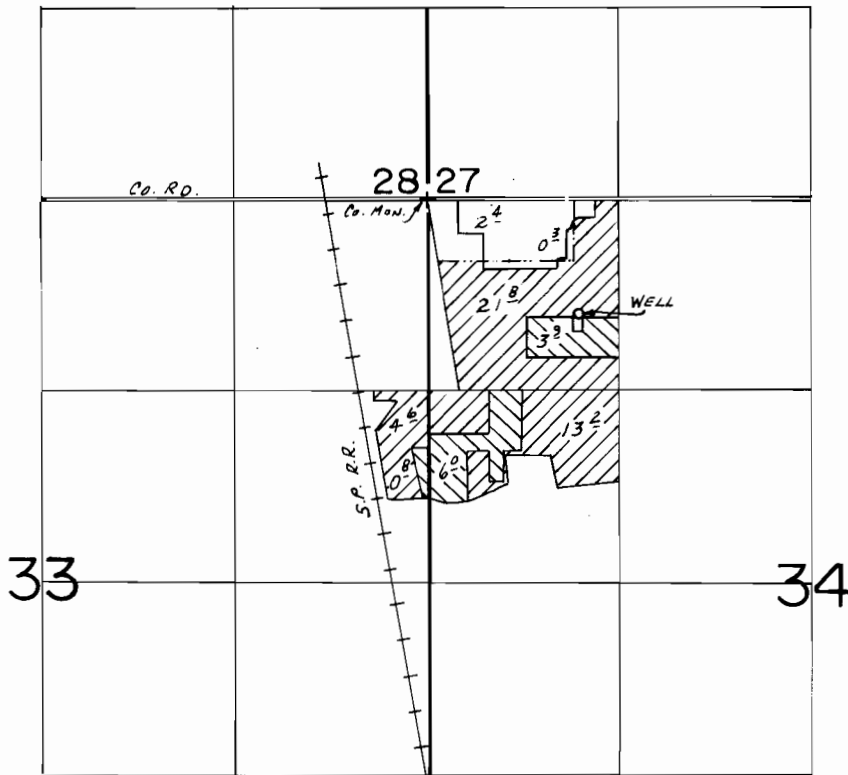


T.5S., R.1W., W.M.

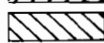

WELL LOC.: 800 S. & 1040 E. FROM THE NW CORNER OF SECTION 34.

-  Primary
-  Supplemental

SCALE: 1" = 1320'

FINAL PROOF SURVEY UNDER

Application No. G-8641. Permit No. G-7950....
IN NAME OF

..... R. T. FESSLER

Surveyed Mar. 25... 1986, by T. M. WARREN....