
T. 22 & 23 S., R. 33 E., WM

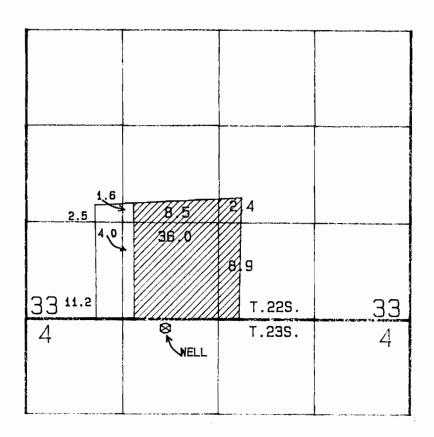

WELL LOCATED: 100 FT SOUTH AND 720 FT WEST FROM THE SOUTH 1/4 CORNER SECTION 33.

SCALE 1 IN = 1320 FT

FINAL PROOF SURVEY

APPLICATION NO.: G-8847 PERMIT NO.: G-8429 IN THE NAME OF

DONALD B. TRUNELL

SURVEYED MAY 20, 1986 BY: LARRY TOLL

COMPUTER DRAFTED: TMW PTS-1986-V-A.