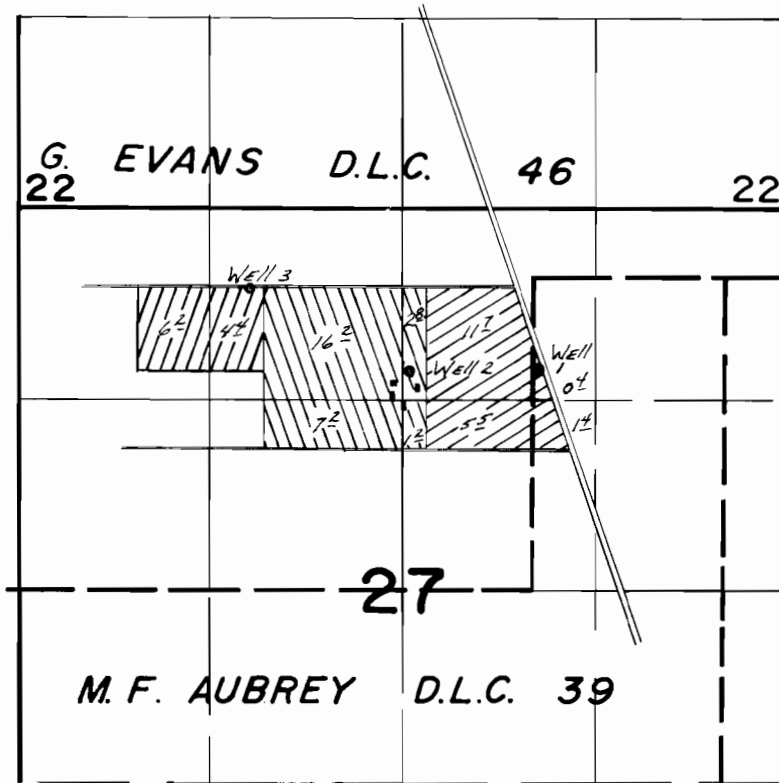

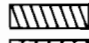



T. 16S. R. 4W.W.M.



-  - Well 1 - 1100'S x 3540'E
 -  - Well 2 - 1100'S x 2700'E
 -  - Well 3 - 550'S x 1600'E
- } ALL FROM NW COR. SEC. 27.

FINAL PROOF SURVEY UNDER

Application No. G-8995 Permit No. G-8459
IN NAME OF

JOHN T. BRICE

Surveyed Oct. 10, 1979, by C. RODRIGUEZ.