


T. 9 S., R. 1 E., W.M.

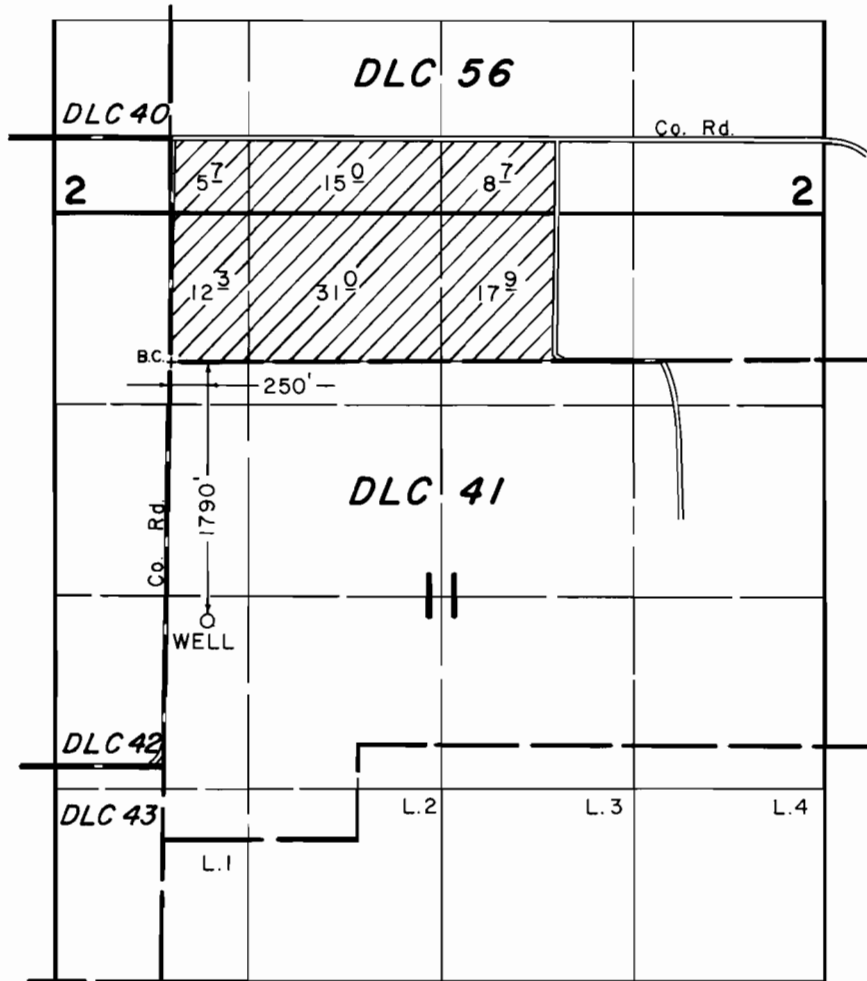

SCALE: 1" = 1320'

FINAL PROOF SURVEY UNDER

Application No. G-9231 Permit No. G-8583...
IN NAME OF

.....RICHARD HARTMANN.....

Surveyed APRIL 23 1985, by P.R. PAGTER...
SEPT. 29 1986 T.M. WARREN
MAY 17, 1990 T.M. WARREN