


T. 40 S., R. 14 W., W. M.

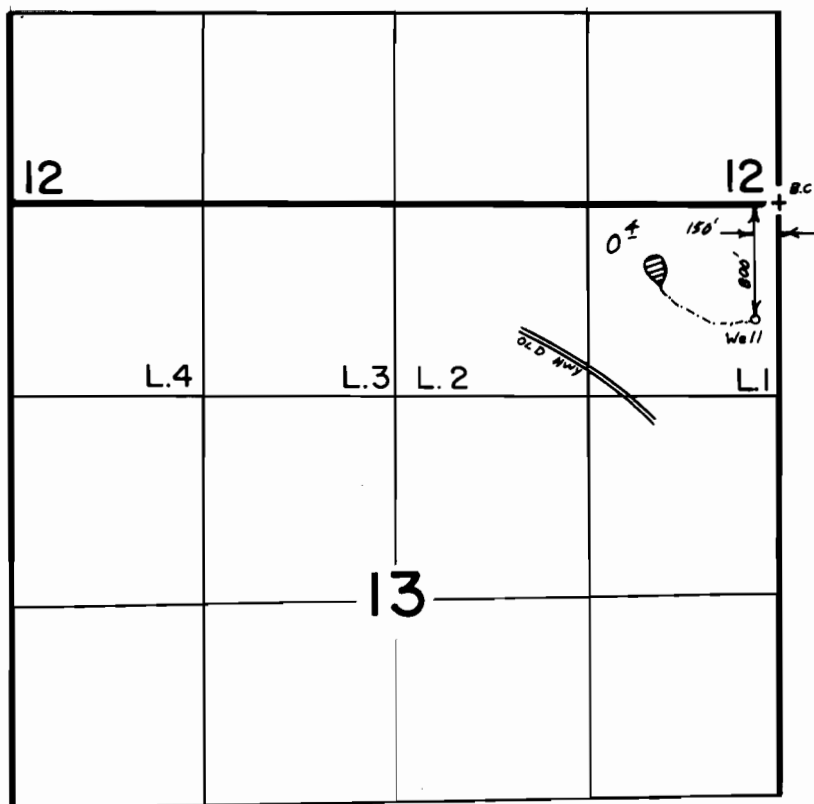

Scale 1"=1320'



FINAL PROOF SURVEY UNDER

Application No. G-9389 Permit No. G-8934
IN NAME OF

MICHAEL & BARBARA HAHN

Surveyed Sept. 29, 1987, by B.S. JAMES