


# T.16S.,R.4W.,W.M.

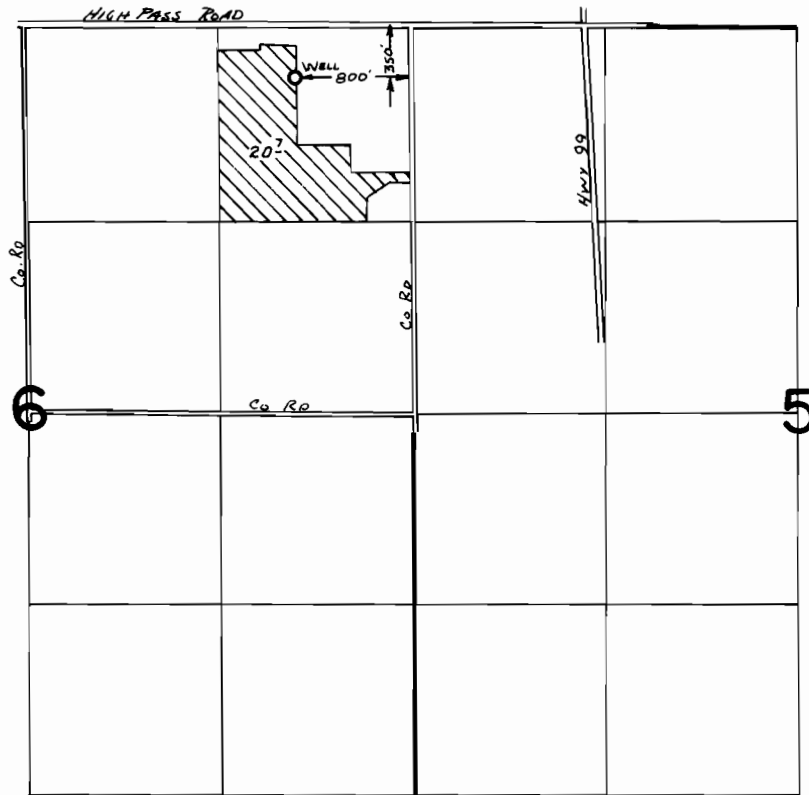

## FINAL PROOF SURVEY UNDER

Application No. G-9629 Permit No. G-9534  
IN NAME OF

ROBERT R. ANDERSON

Surveyed June 16, 1982, by L. M. TOLL