


T. 25 S., R. 19 E., W.M.

N

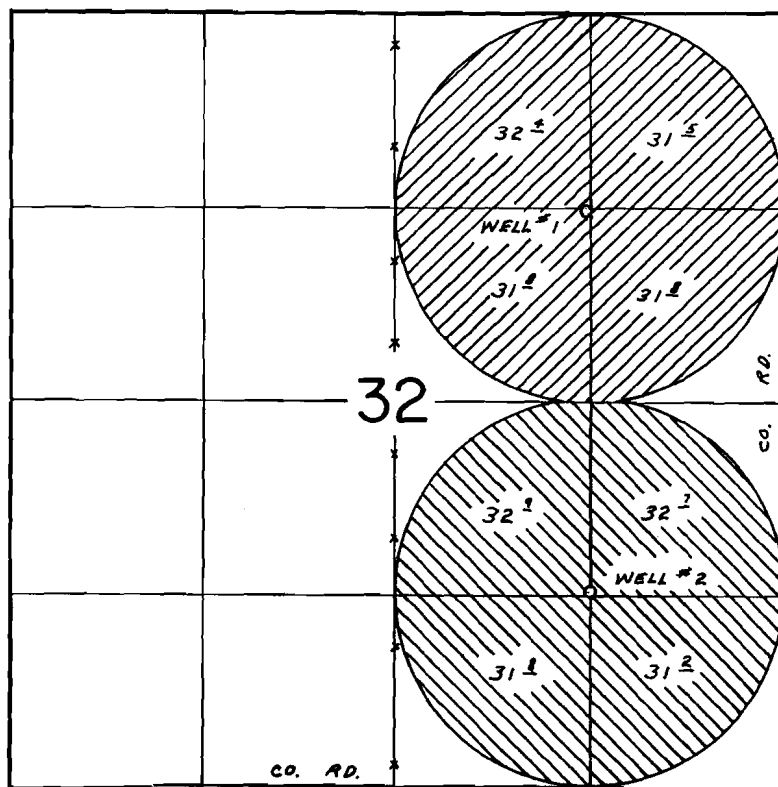

WELL NO. 1 LOC.: 1350' S. & 1340' W. FROM NE COR. SEC. 32
 WELL NO. 2 LOC.: 1350' N & 1330' W. FROM SE COR. SEC. 32

SCALE: 1"=1320'

WELL NO. 1

WELL NO. 2

FINAL PROOF SURVEY

UNDER

Application No. G-9806 Permit No. G-8916.....
 IN NAME OF

GEORGE & BARBARA WARMINGTON

Surveyed APR. 17 1985, by L. OLSON
AUG. 29 1988 B. BISHOP