


T.10S.,R.38&4W.,W.M.

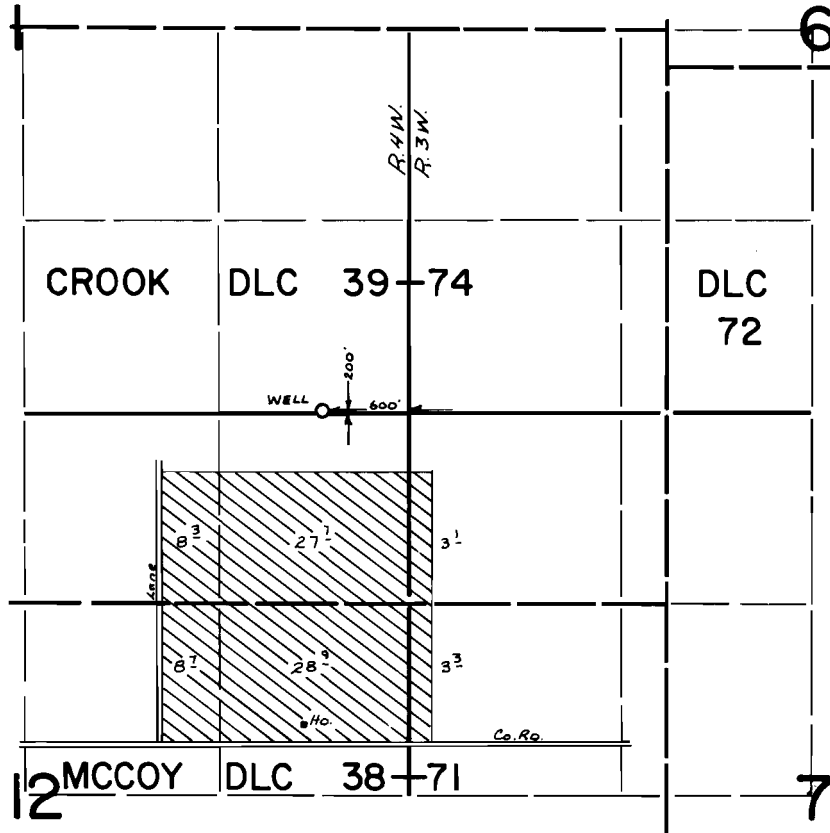

FINAL PROOF SURVEY
UNDER

Application No. G-10069 Permit No. G-9560.....
IN NAME OF

ELMER COOK

Surveyed July 27... 1982., by L.M.TOLL.....