
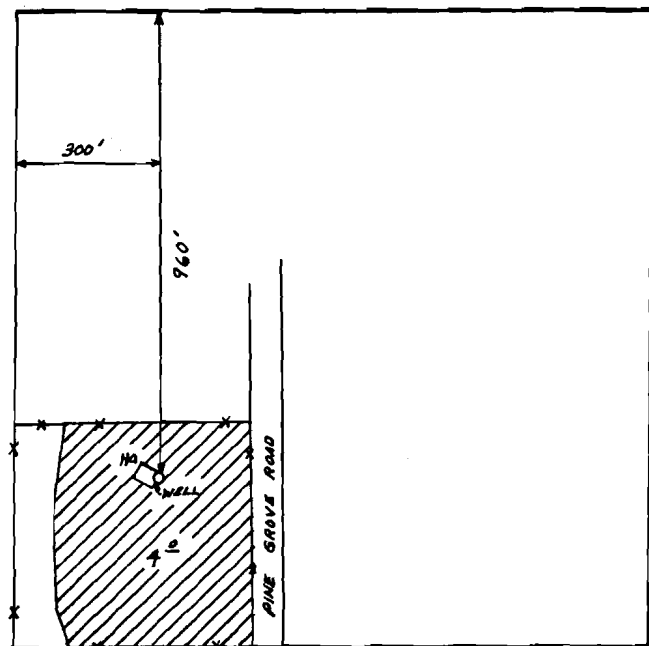


T. 39 S., R. 10 E., W. M.
NW 1/4 NE 1/4 SEC. 9

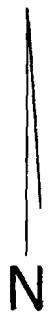

SCALE: 1" = 400'

FINAL PROOF SURVEY
UNDER

Application No. G-10084 Permit No. G-9206.....
IN NAME OF

EARL D. & BEVERLY J. KURTZ

Surveyed AUG. 19... 1987.. by B. BISHOP.....

East River Wells