


T. 18S., R. 45E., W.M.

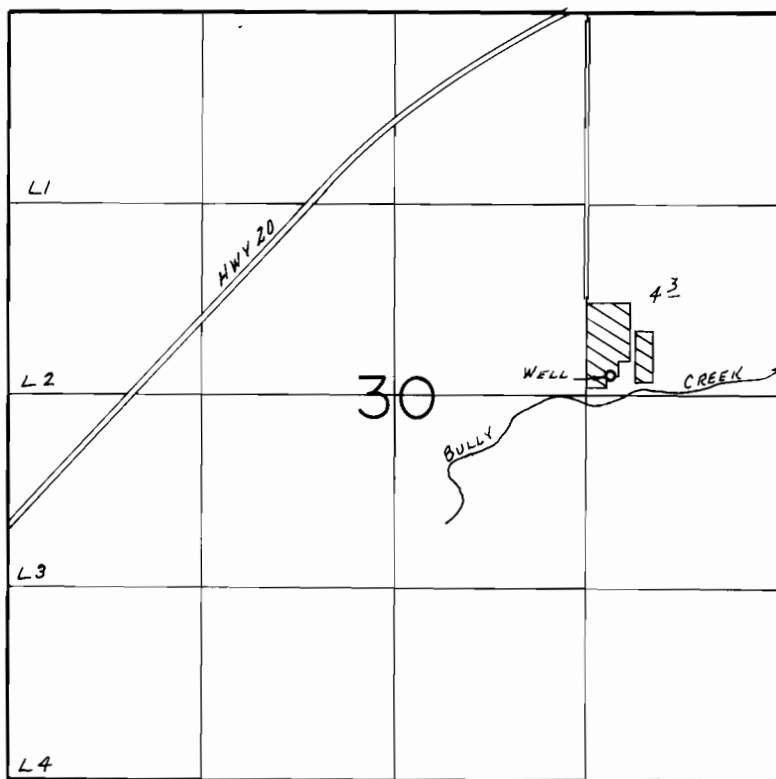

WELL LOC.: 140' N & 1150' W FROM E 1/4 COR. SEC. 30.

SCALE: 1"=1320'

FINAL PROOF SURVEY UNDER

Application No. G-10191.. Permit No. G-10288...
IN NAME OF

.....EUGENE BECKER.....

Surveyed APR. 16... 19.86, by L.M.TOLL.....

2/25/87
BWB