


65944

T. 40S., R.1E., W.M.

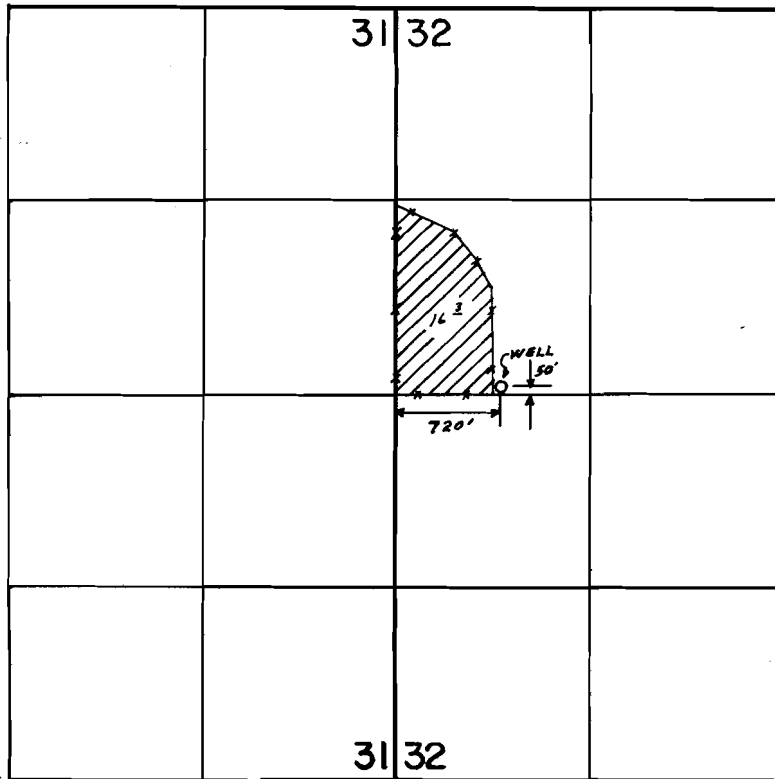


N

SCALE: 1"=1320'

FINAL PROOF SURVEY UNDER

Application No. G-10195 Permit No. G-9243.....
IN NAME OF

GARY D. OREM.....

Surveyed AUG. 18 1987, by V.L. CHURCH.....